


T.29S. R.5W. W.M.

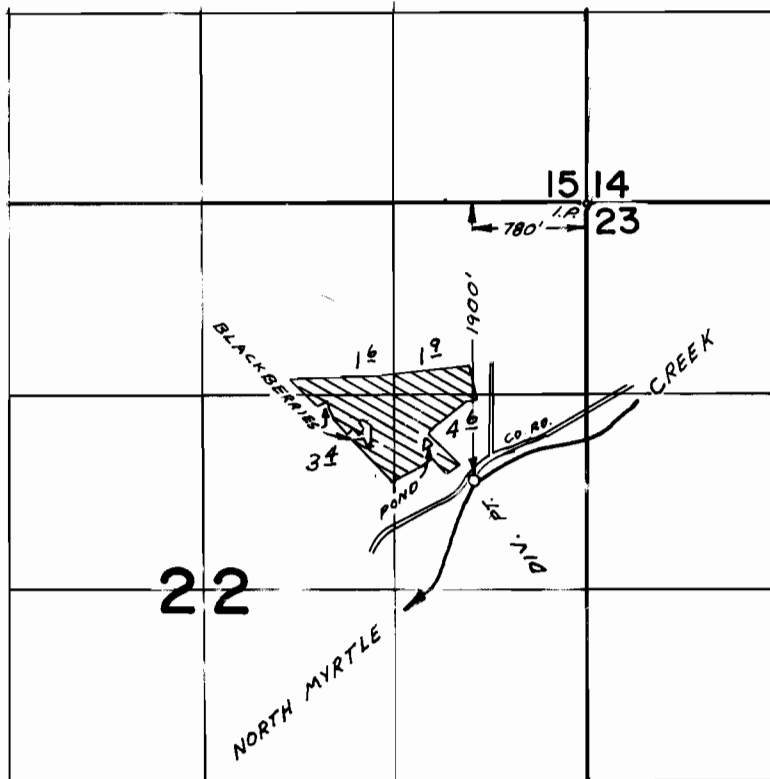

**FINAL PROOF SURVEY**  
UNDER

Application No. 50280 Permit No. 37964  
IN NAME OF

**KENNETH R. & MARGARETE SCHMIDT**

Surveyed OCT. 7, 1976, by L.H. NUNN