


T.26S., R.4W., W.M.

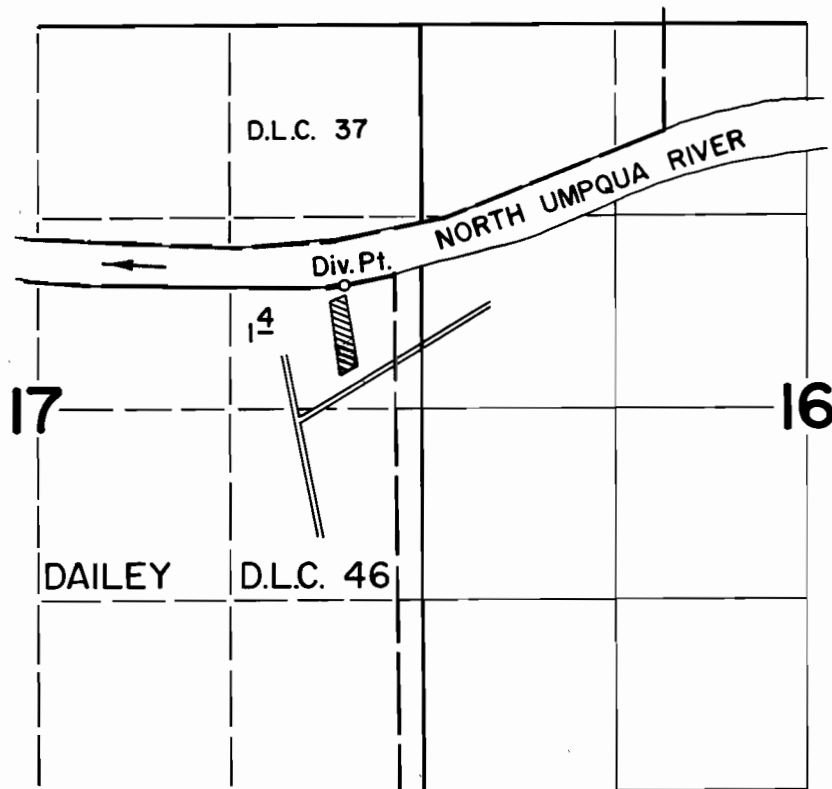

DIV. PT. LOC: 1790' S & 530' W FROM NE COR. SEC. 17

FINAL PROOF SURVEY UNDER

Application No. 50303 Permit No. 37981
IN NAME OF

ED R. BARRETT

Surveyed April 6, 1976, by D. Norby