


T.25S.R.7W.W.M.

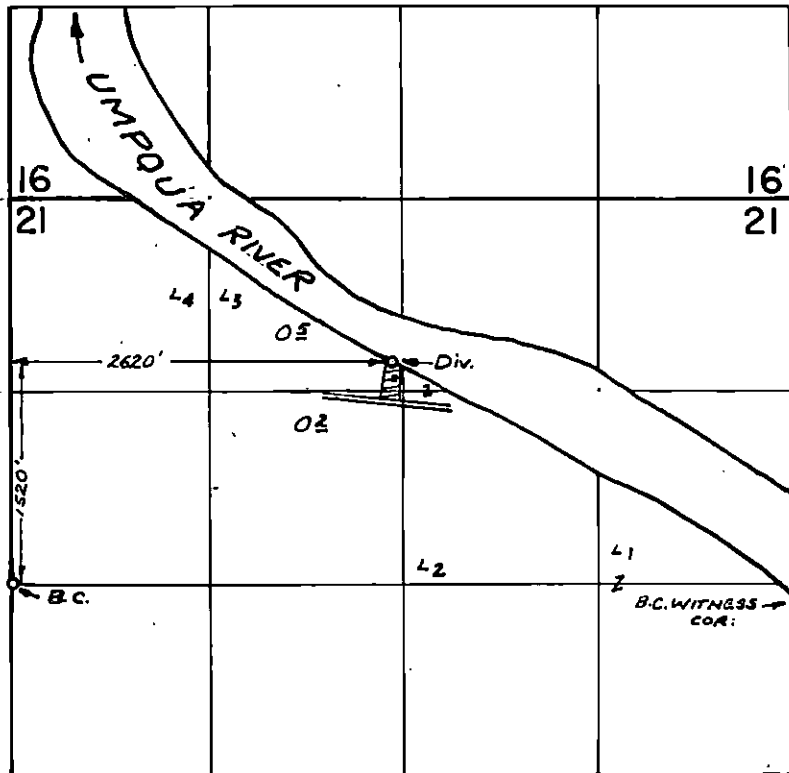

FINAL PROOF SURVEY UNDER

Application No. *50623*... Permit No. *39254*
IN NAME OF

CLAYTON K. & MARGUERITE R. HAYES

Surveyed *MAY 27, 1976*, by *R. MURKEN*.