


# T.22S.R.8W.W.M.

SECTION 21

1" = 660'

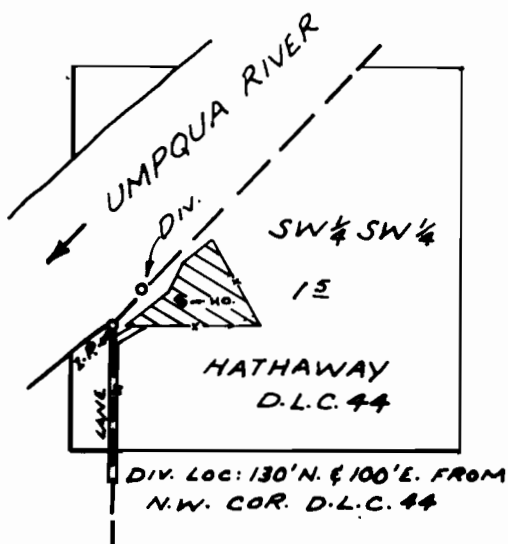

## FINAL PROOF SURVEY UNDER

Application No. 50696 Permit No. 39293  
IN NAME OF

MERLE C. GODDING

Surveyed MAY 11, 1976, by R. MUCKEN