


T.28S., R.8W., W.M.

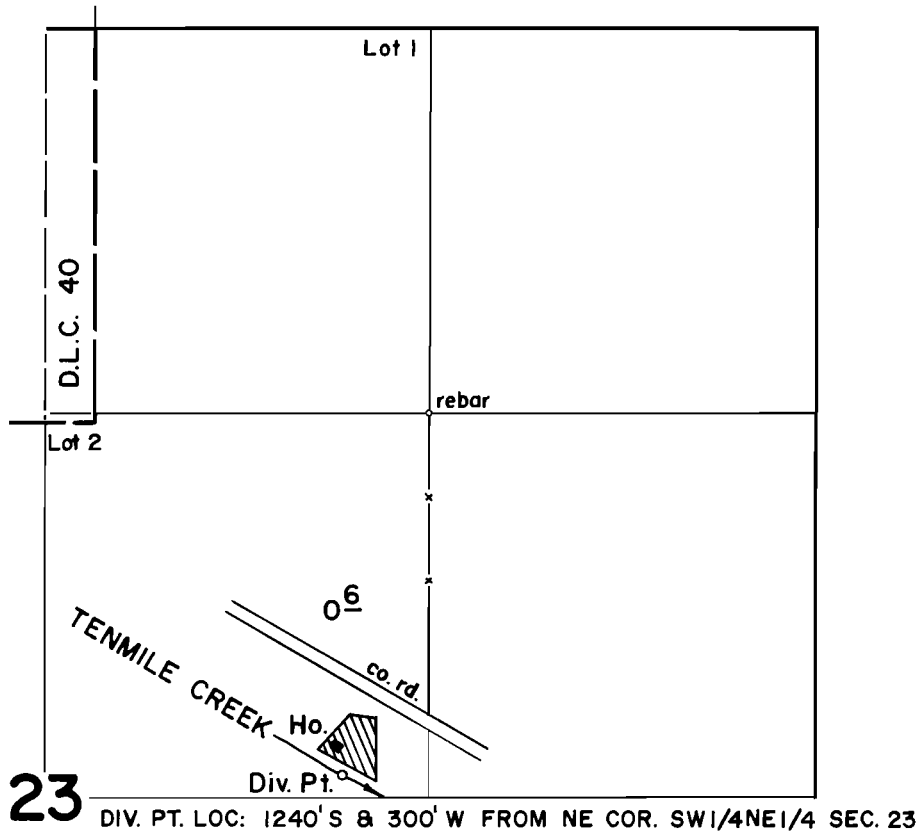

Scale: 1" = 660'

**FINAL PROOF SURVEY**  
UNDER

Application No. 50939 Permit No. 38458  
IN NAME OF

DON W. & MARCIA C. WEAVER

Surveyed Oct. 13 1976, by D. Norby