


T.30S. R.5W. W.M.

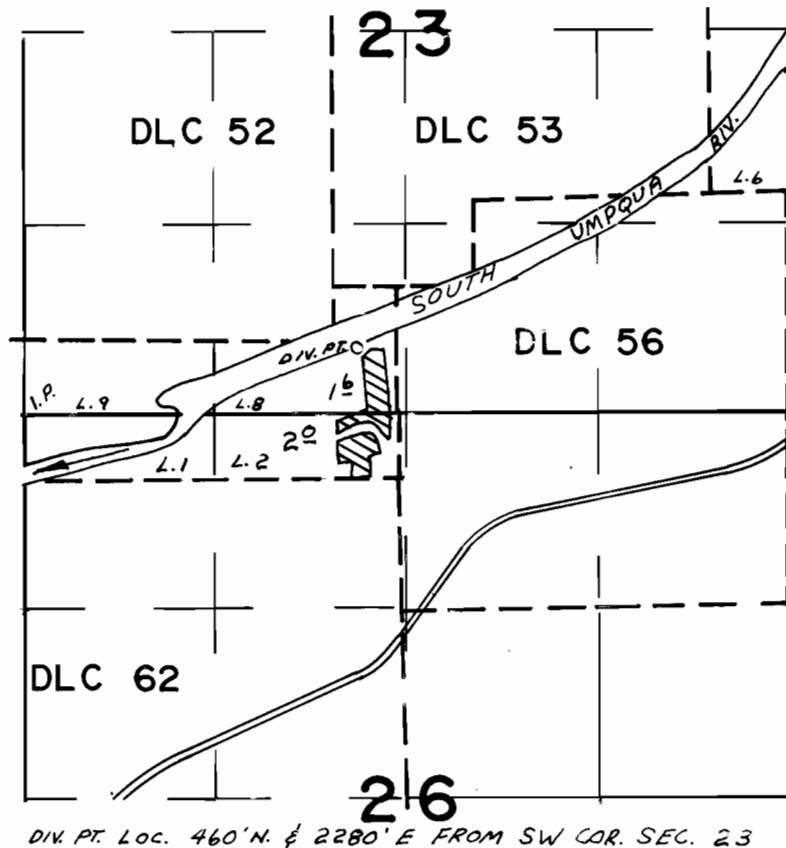

**FINAL PROOF SURVEY**  
UNDER

Application No. 50985... Permit No. 38482...  
IN NAME OF

FRED F. HOOPER

Surveyed OCT. 5... 1976, by L.H. NUNN