


T.28S. R.4 W. W.M.

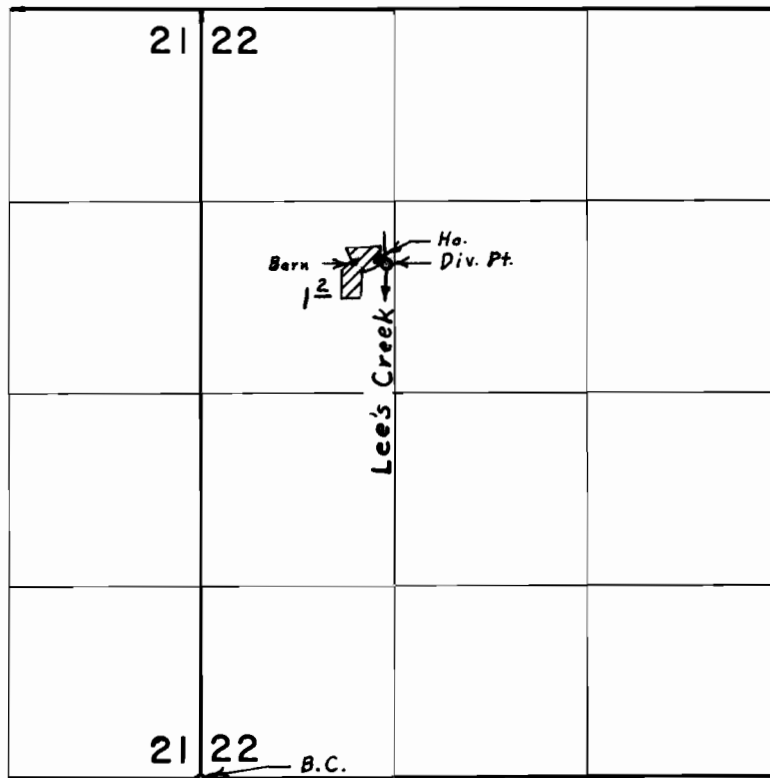

Div. Pt. located 3530' N. & 1270' E. from S.W. Cor. Sec. 22

FINAL PROOF SURVEY
UNDER

Application No. 50924 Permit No. 38489
IN NAME OF
STANLEY, LOUISE & IRENE ZENEV
Surveyed July 28, 19, by L. E. Gould