


# T.27S., R.4W., W.M.

CHNGD TO INSP  
DRAFTING DOES  
NOT KREC  
WITH PLAT  
ON APPL. MAP

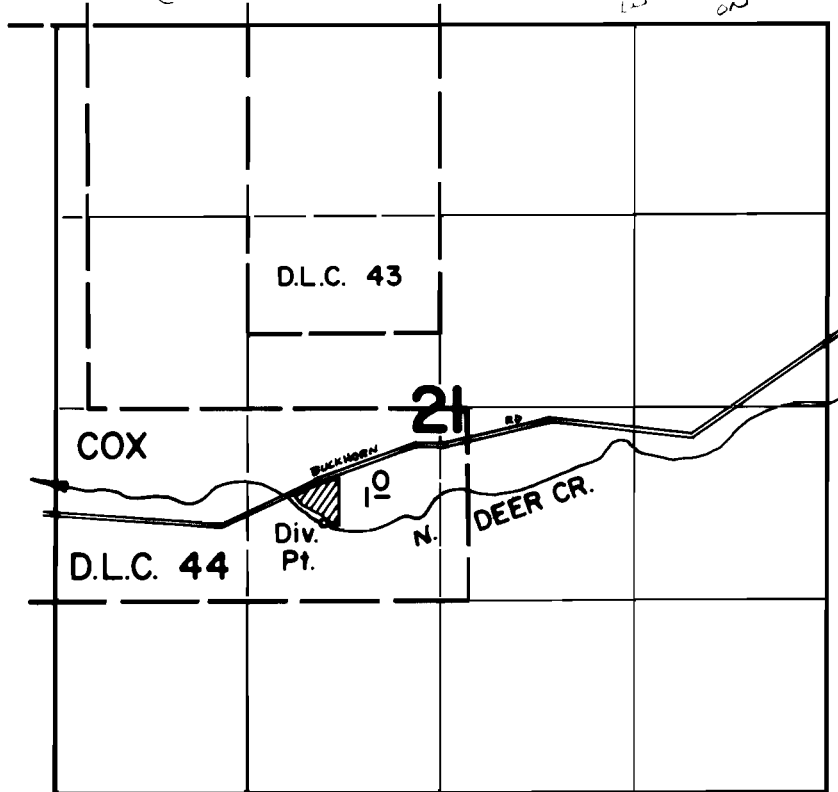

DIV. PT. LOC: 540' N & 990' W FROM SE COR. COX D.L.C. 44

## FINAL PROOF SURVEY UNDER

Application No. 51132 Permit No. 38650  
IN NAME OF

KENNETH D. & CAROLE P. SCOTT

Surveyed April 5 1976, by D. Norby