


T.21&22S.R.5W.W.M.

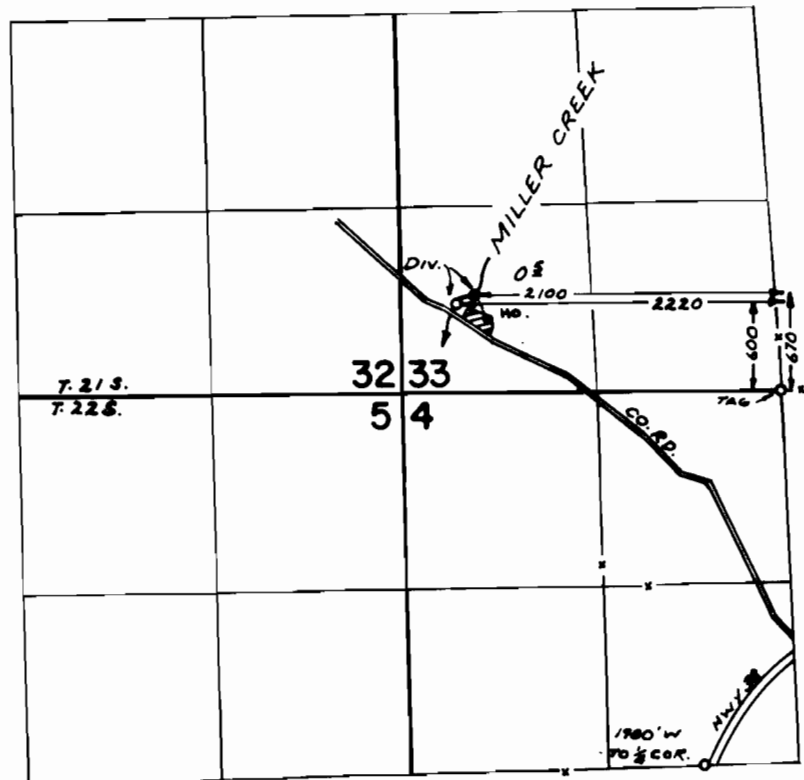

FINAL PROOF SURVEY
UNDER

Application No. 51164 Permit No. 38667
IN NAME OF

EDMUND & JAUNITA M. CLARK

Surveyed MAY 25 1976, by R. MUGKEN