


T.24S.R.5W.W.M.

SECTION 7

1" = 660'

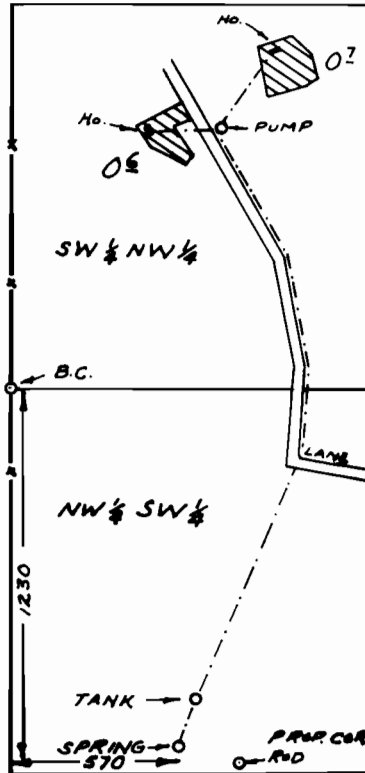

FINAL PROOF SURVEY UNDER

Application No. 51211..... Permit No. 38673...
IN NAME OF

ALBERT & DOROTHY TEEPLE & DONALD & BETTY McCRARY

Surveyed MAY 26, 1976., by R. MUCKEN