


T.28S. R.6W. W.M.

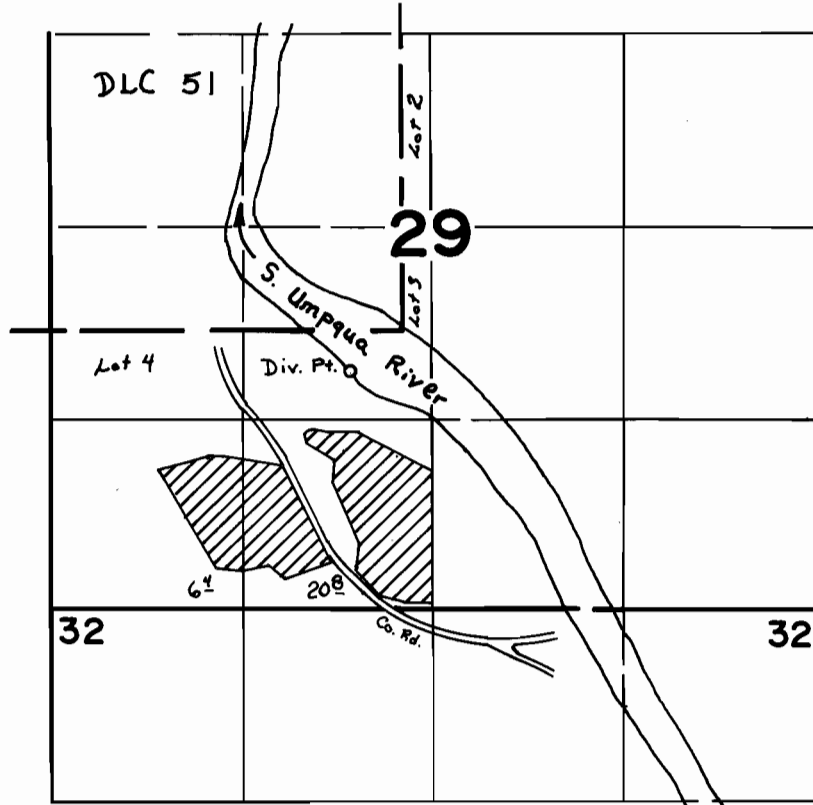

Div. Pt. Located 1000'S & 550'W from C¹/₄ cor Sec 29

FINAL PROOF SURVEY
UNDER

Application No. 51819 Permit No. 39025
IN NAME OF

ABNER J. RICE

Surveyed July 28, 1976, by L. E. Gould