


T.28S., R.6W., W.M.

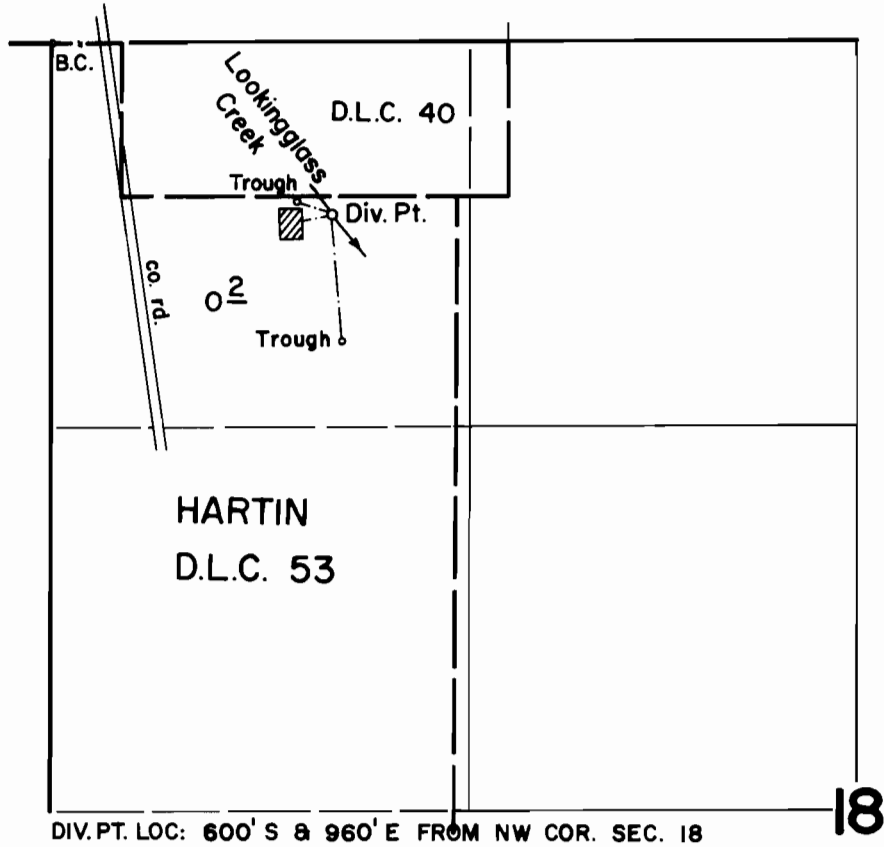

Scale: 1" = 660

FINAL PROOF SURVEY UNDER

Application No. 52024 Permit No. 39210
IN NAME OF

OTTO R. WEISZ

Surveyed Oct. 14 1976, by D. Norby