


T.24S., R.7W., W.M.

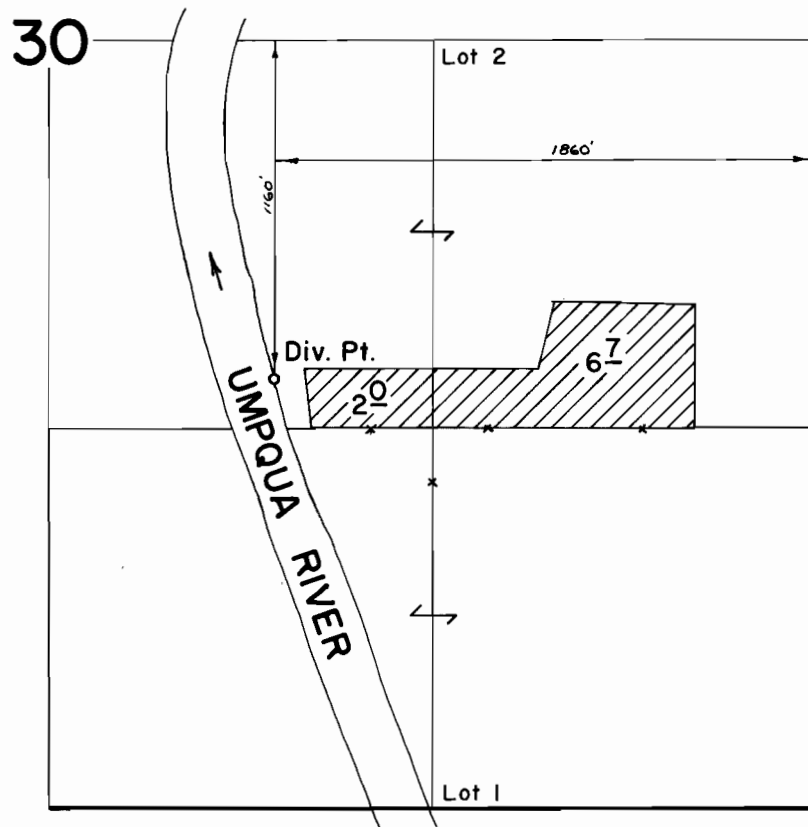

Scale: 1" = 660'

FINAL PROOF SURVEY
UNDER

Application No. 52458 Permit No. 39448
IN NAME OF

KERWIN L. DOUGHTON

Surveyed July 29 1976, by D. Norby