


# T.22S.R.7W.W.M.

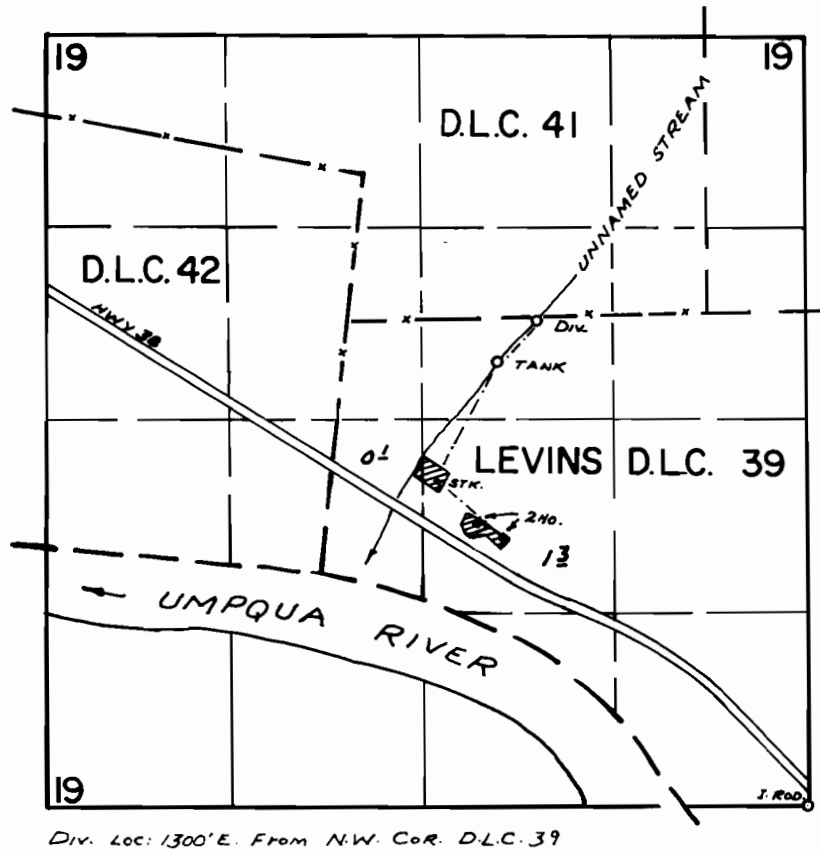

## FINAL PROOF SURVEY UNDER

Application No. 52673 Permit No. 37749  
IN NAME OF

ZEB WILLARD & BEVERLY ARLENE AMMONS

Surveyed MAY 11, 1976, by R. MUCKEN