


T.25S., R.6W., W.M.

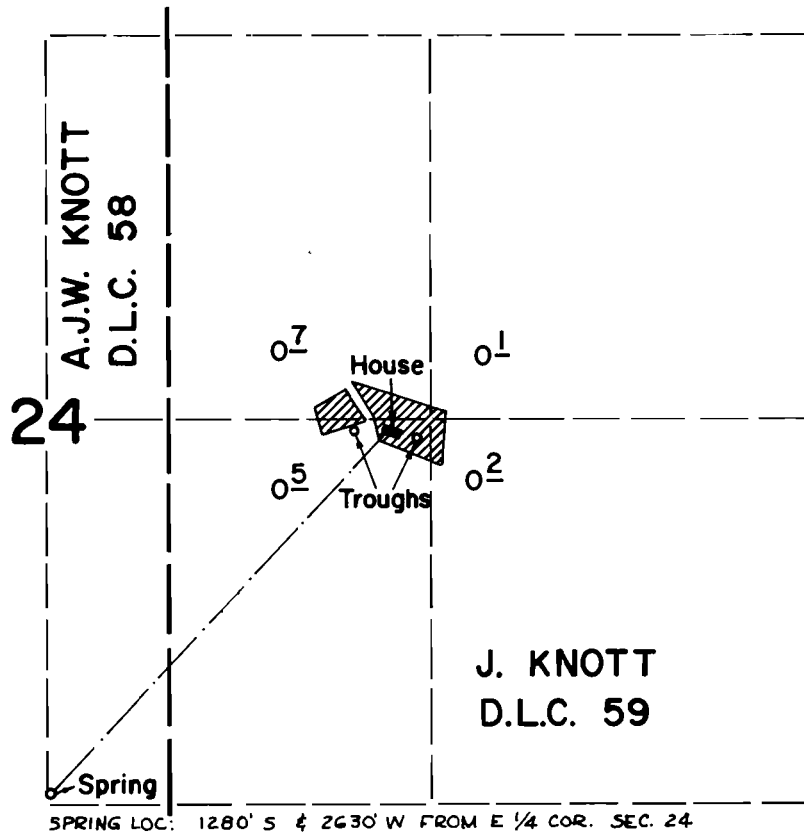

Scale: 1" = 660'

FINAL PROOF SURVEY UNDER

Application No. 52674 Permit No. 39826
IN NAME OF

ROBERT D. BLANCHFIELD

Surveyed July 30 1976, by D. Norby