


T.23S., R.4W., W.M.

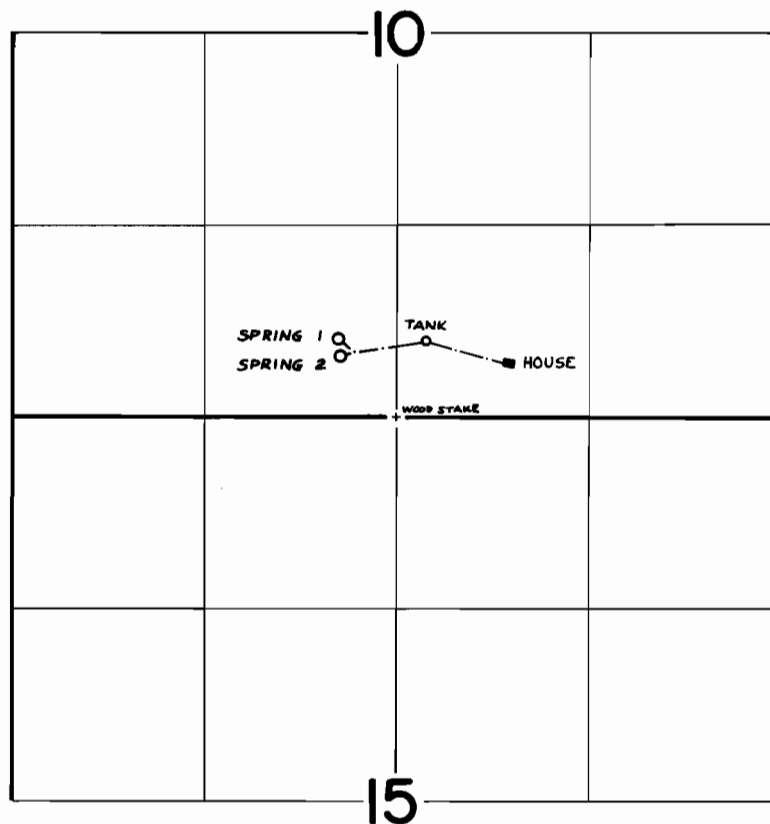

SPRINGS LOC: 1 - 540' N & 400' W; 2 - 420' N & 380' W BOTH FROM S 1/4 COR. SEC. 10

Scale: 1" = 660'

FINAL PROOF SURVEY
UNDER

Application No. 52740 Permit No. 39711
IN NAME OF

MARTIN AND CORA CONLEY

Surveyed July 27 1976, by D. Norby