


T.28S., R.4W., W.M.

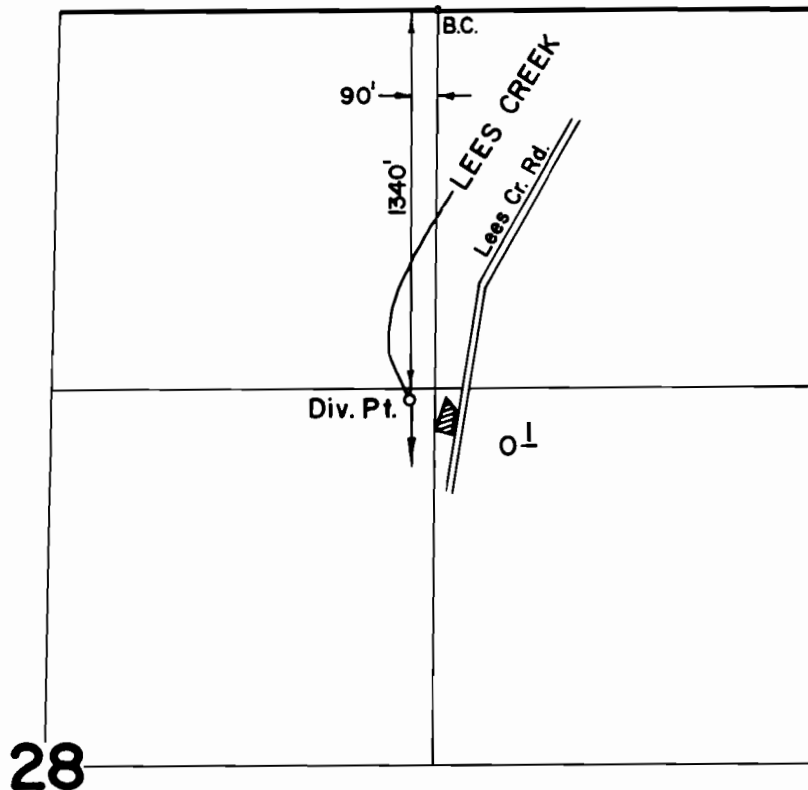

Scale: 1" = 660'

FINAL PROOF SURVEY
UNDER

Application No. 52785 Permit No. 39729
IN NAME OF

CARL H. MOE

Surveyed Oct. 15 1976, by D. Norby