
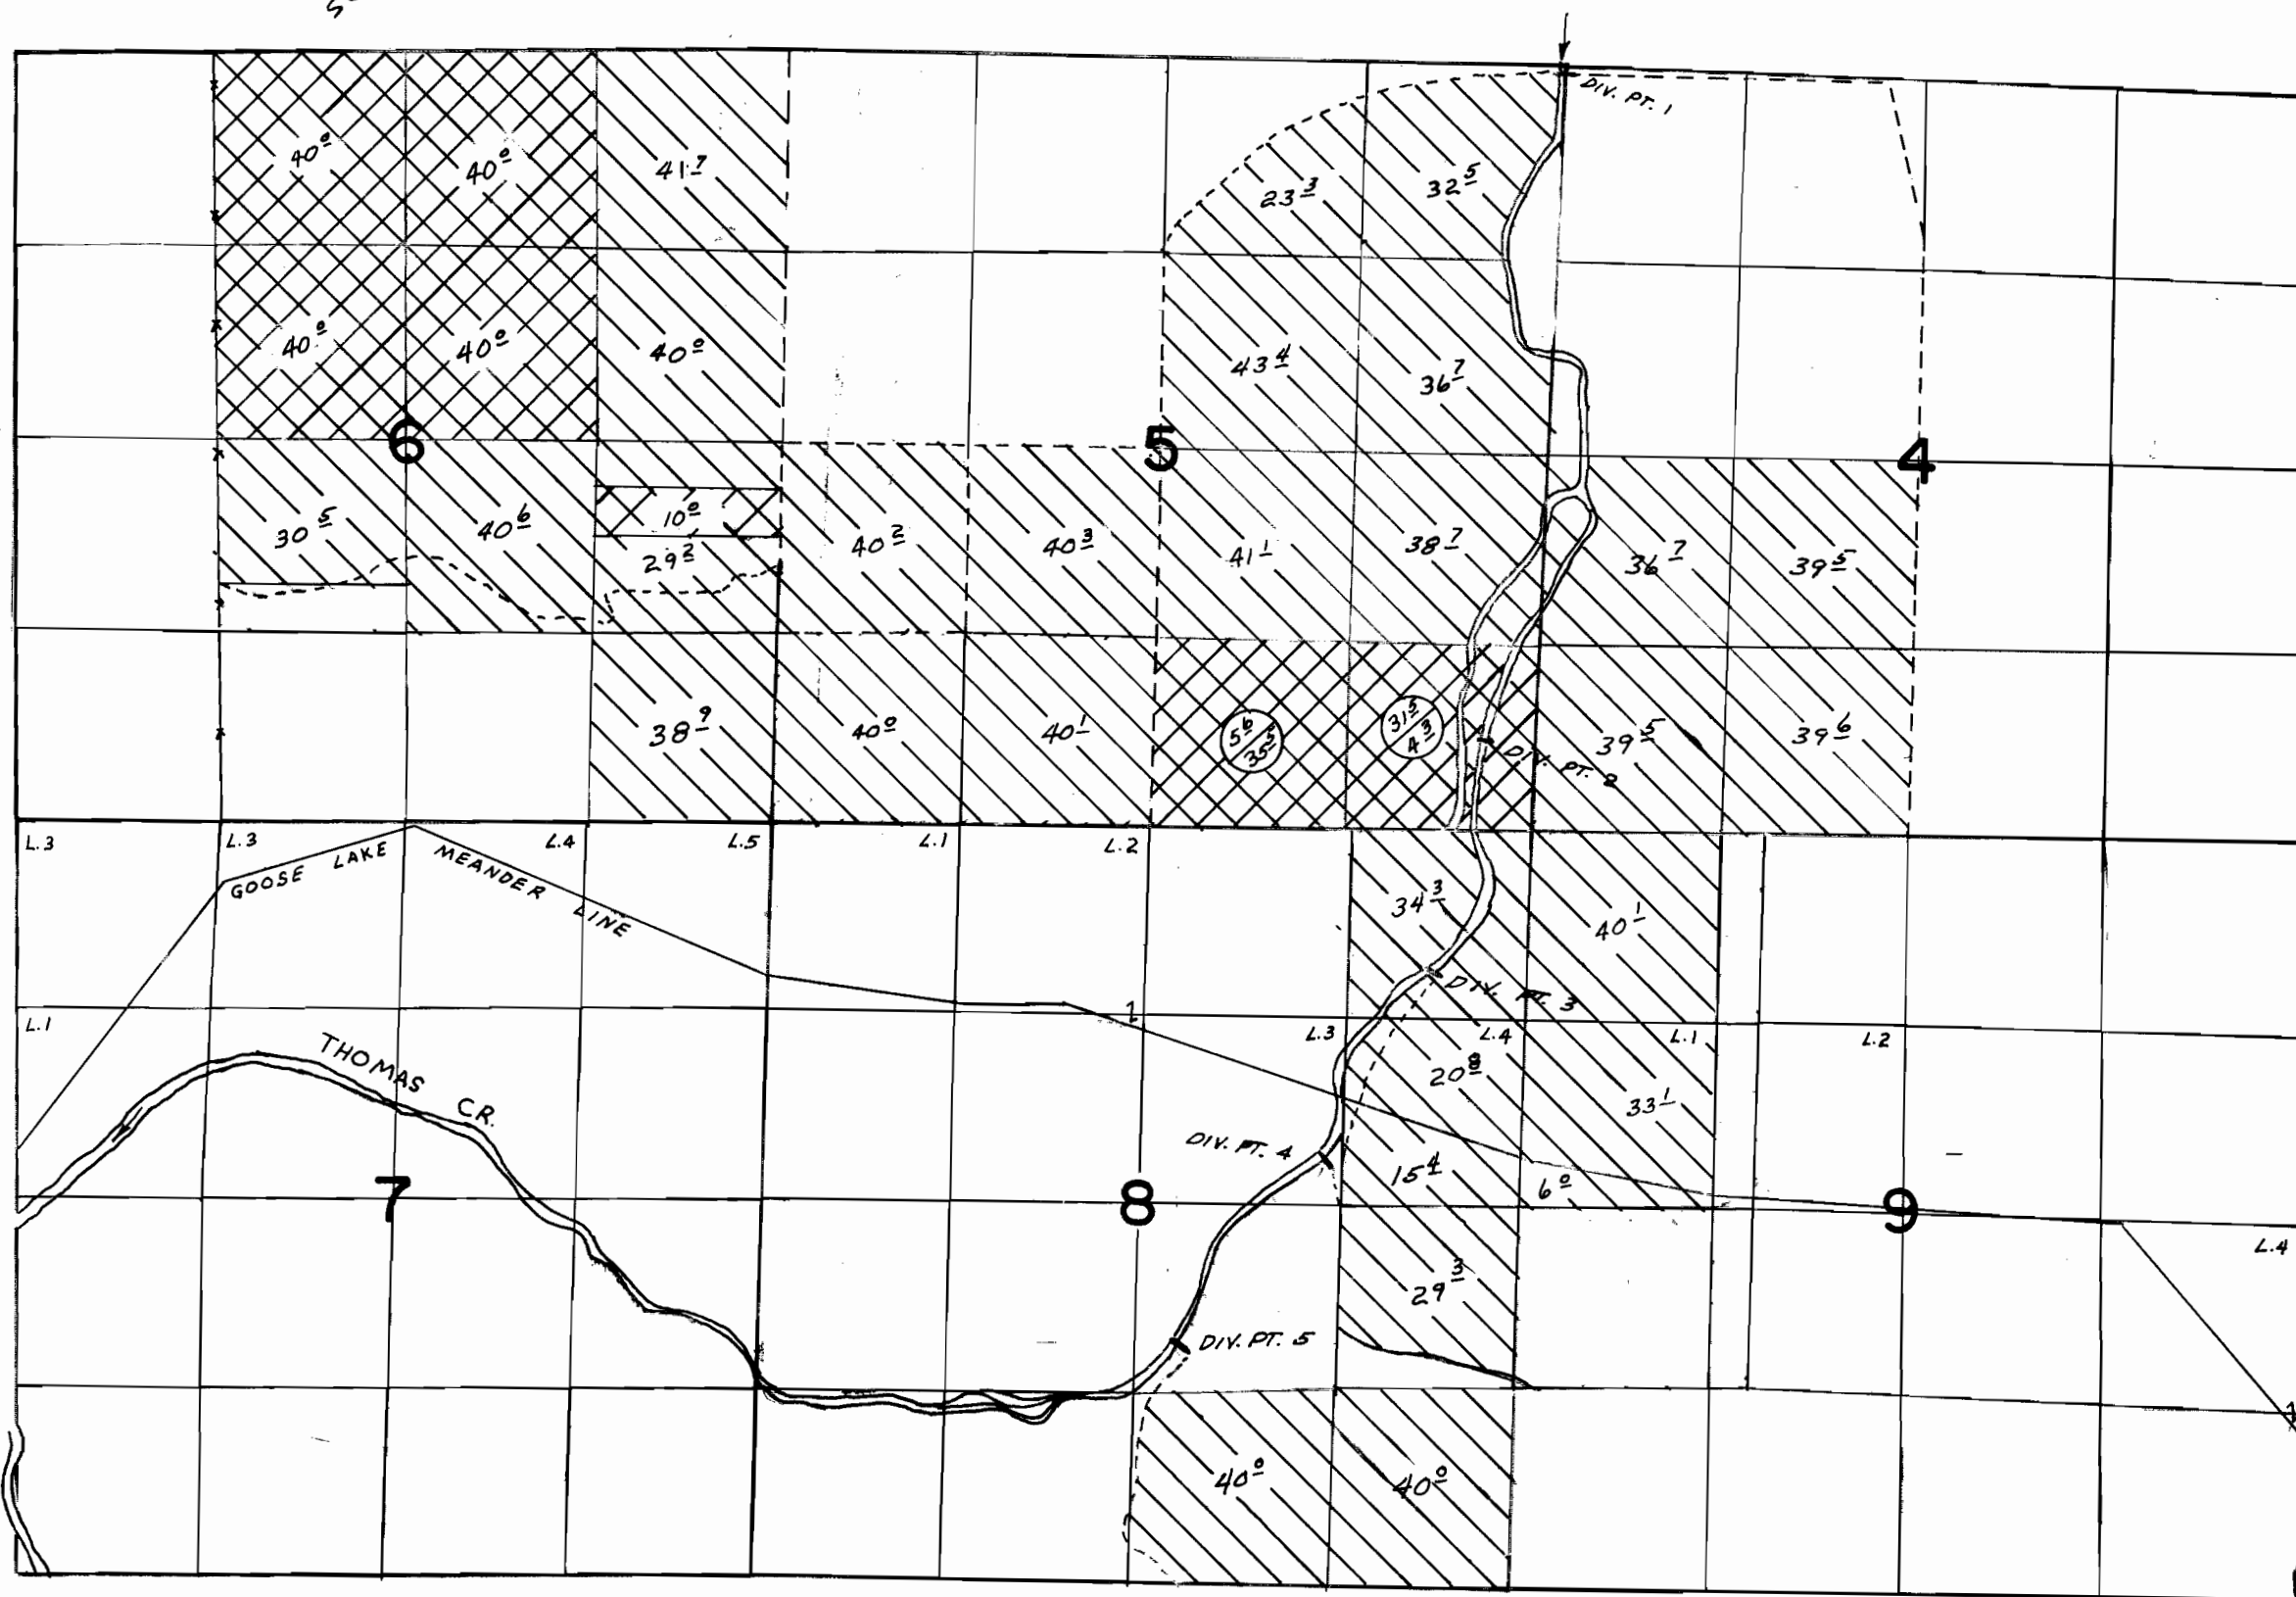
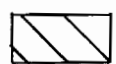


OUT OF
SCALE

T.40S. R.20E. W.M.

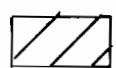

 THOMAS CR.

 COTTONWOOD CR.

 PRIMARY
 SUPPLEMENTAL

FINAL PROOF SURVEY

UNDER

APPLICATION NO. 40959 PERMIT NO. 30713

IN THE NAME OF

LYLE W. & FRANKIE GARRETT

SURVEYED JULY 10, 1975 BY L.H. NUNN

DIV. PTS. LOCATED

1- 50'S. & 30' W.

2- 4700' S. & 560' W.

3- 6300' S. & 900' W.

4- 7600' S. & 1680' W.

5- 8890' S. & 2700' W.

FROM NE COR. SEC. 5