


T.17S. R.2W. W.M.

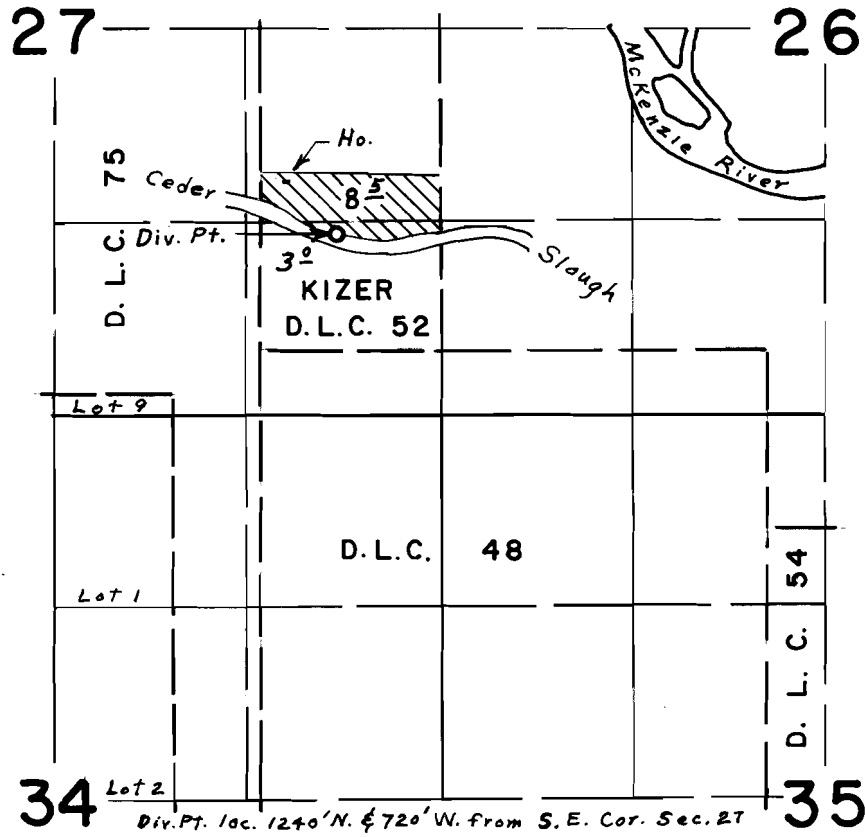

FINAL PROOF SURVEY
UNDER

Application No. 50652 Permit No. 38268
IN NAME OF
J. C. JOHNSON

Surveyed June 21, 1976, by L. E. Gould