


T.18 S. R.3 W. W.M.

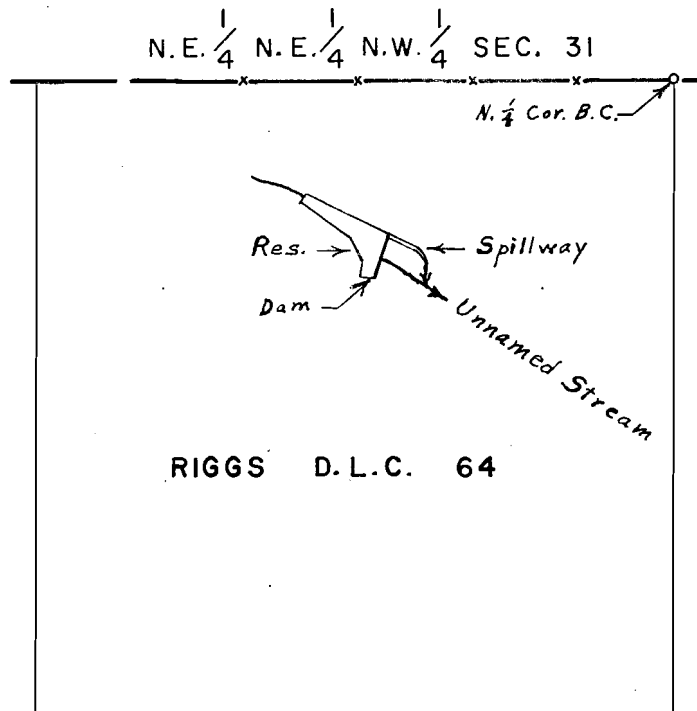

Div. Pt. loc. 105'S. & 305'W. from N. $\frac{1}{4}$ Cor. Sec. 31

SCALE 1" = 200'

FINAL PROOF SURVEY

UNDER

R-51370 R - 6232
Application No. 51371 Permit No. 38821...
IN NAME OF

HAROLD & LOIS BARTON

Surveyed June 24, 1976, by L. E. Gould.