


# T.17 S. R.9 W. W.M.

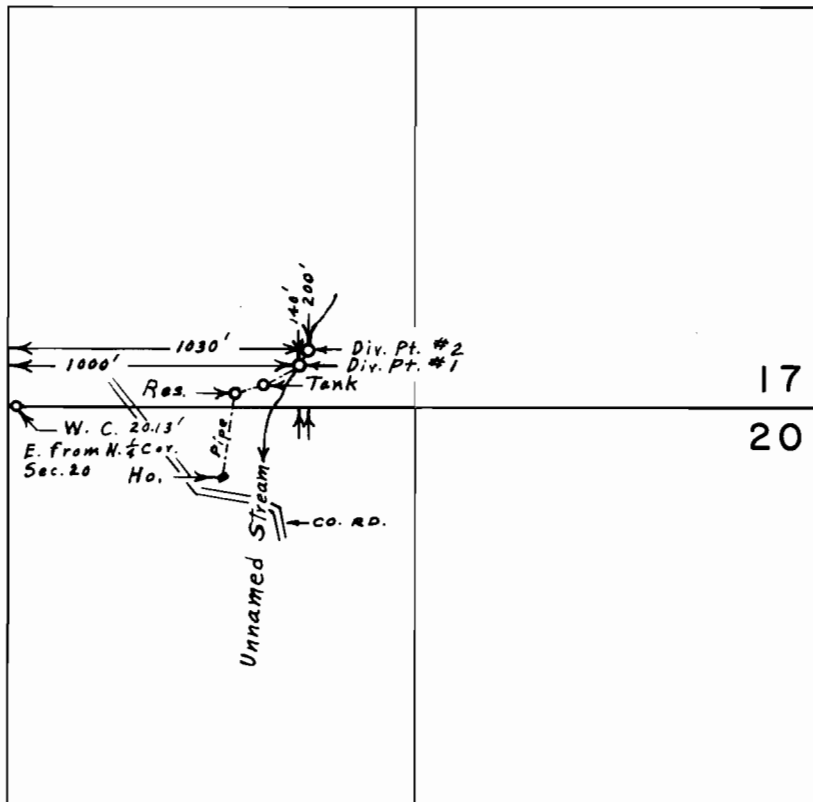

Scale - 1" = 660'

## FINAL PROOF SURVEY UNDER

Application No. 51795. Permit No. 39019.  
IN NAME OF

WILBERT S. FRAZIER

Surveyed Aug. 3, 1976, by L. E. Gould.