


T.18 S. R.1 W. W.M.

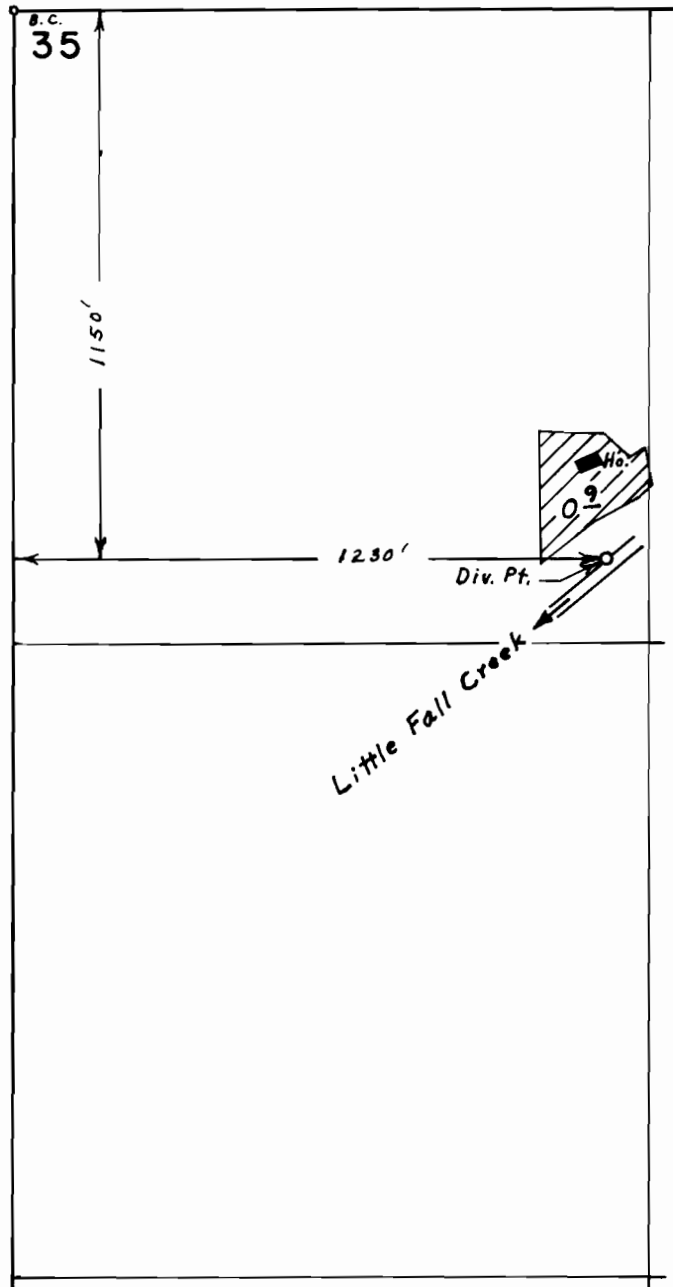

Scale - 1" = 400'

FINAL PROOF SURVEY
UNDER

Application No. 52370 Permit No. 39400
IN NAME OF

RONALD OR MARION BOWMAN

Surveyed June 25, 1976, by L. E. Gould