


T.18S.,R.10W.,W.M.

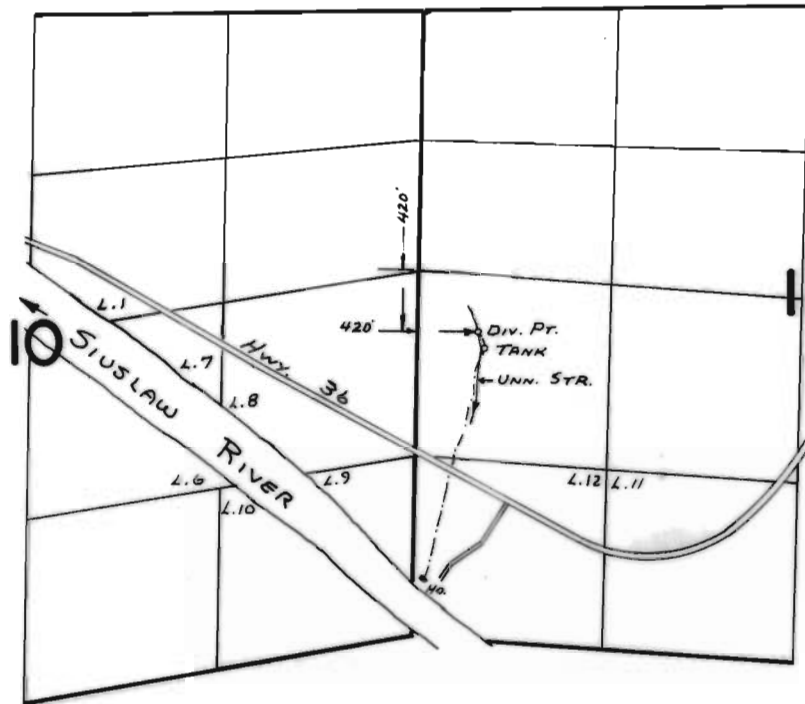

FINAL PROOF SURVEY UNDER

Application No. 52685 Permit No. 39691
IN NAME OF

DAVIDSON INDUSTRIES, INC.

Surveyed Aug. 6 1976, by L. E. GOULD