


T.17S. R.2W. W.M.

20

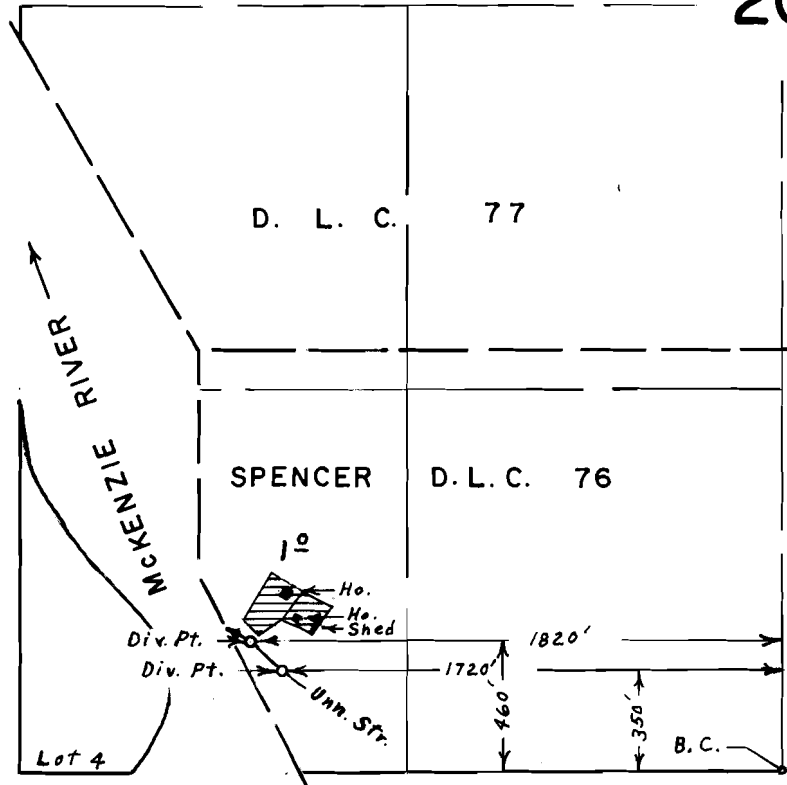

Scale - 1" = 660'

FINAL PROOF SURVEY
UNDER

Application No. 53144 Permit No. 38776
IN NAME OF

ELEANOR HAMBLÉN

Surveyed June 22, 1976, by L. E. Gould