


# T.16S.R.4W.W.M.

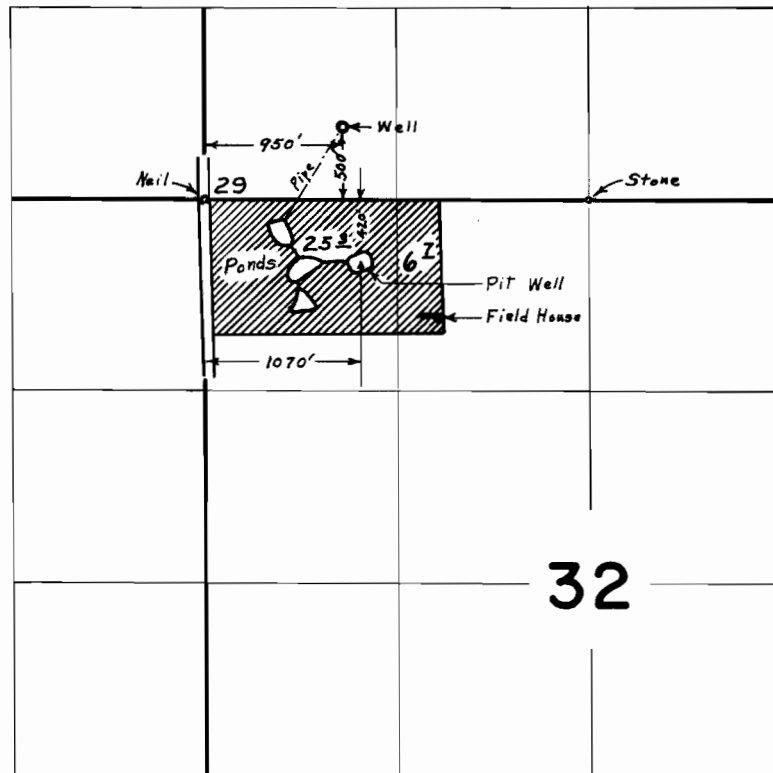

## FINAL PROOF SURVEY UNDER

Application No. G-3306 Permit No. G-3079  
IN NAME OF  
**BEN & VIRGINIA SIMPSON**

Surveyed April 26, 1967, by L. E. Gould