


T.7S.,R.10W.,W.M.

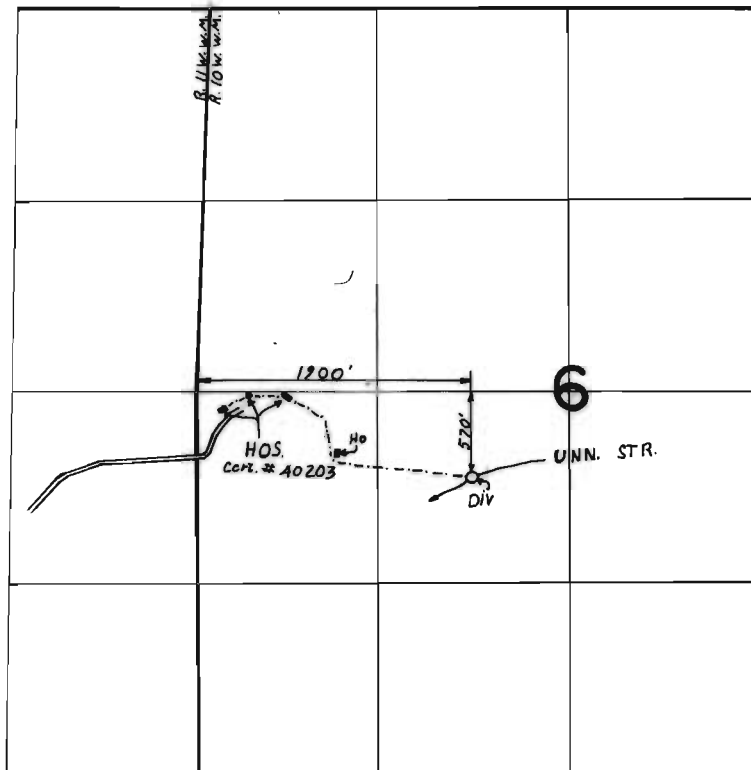

FINAL PROOF SURVEY UNDER

Application No. 48777 Permit No. 36574
IN NAME OF

R. L. KIVETT

Surveyed JULY...2.. 1976., by C.R...KING