


T. 30 S. R. 46 & 47 E. W.M.

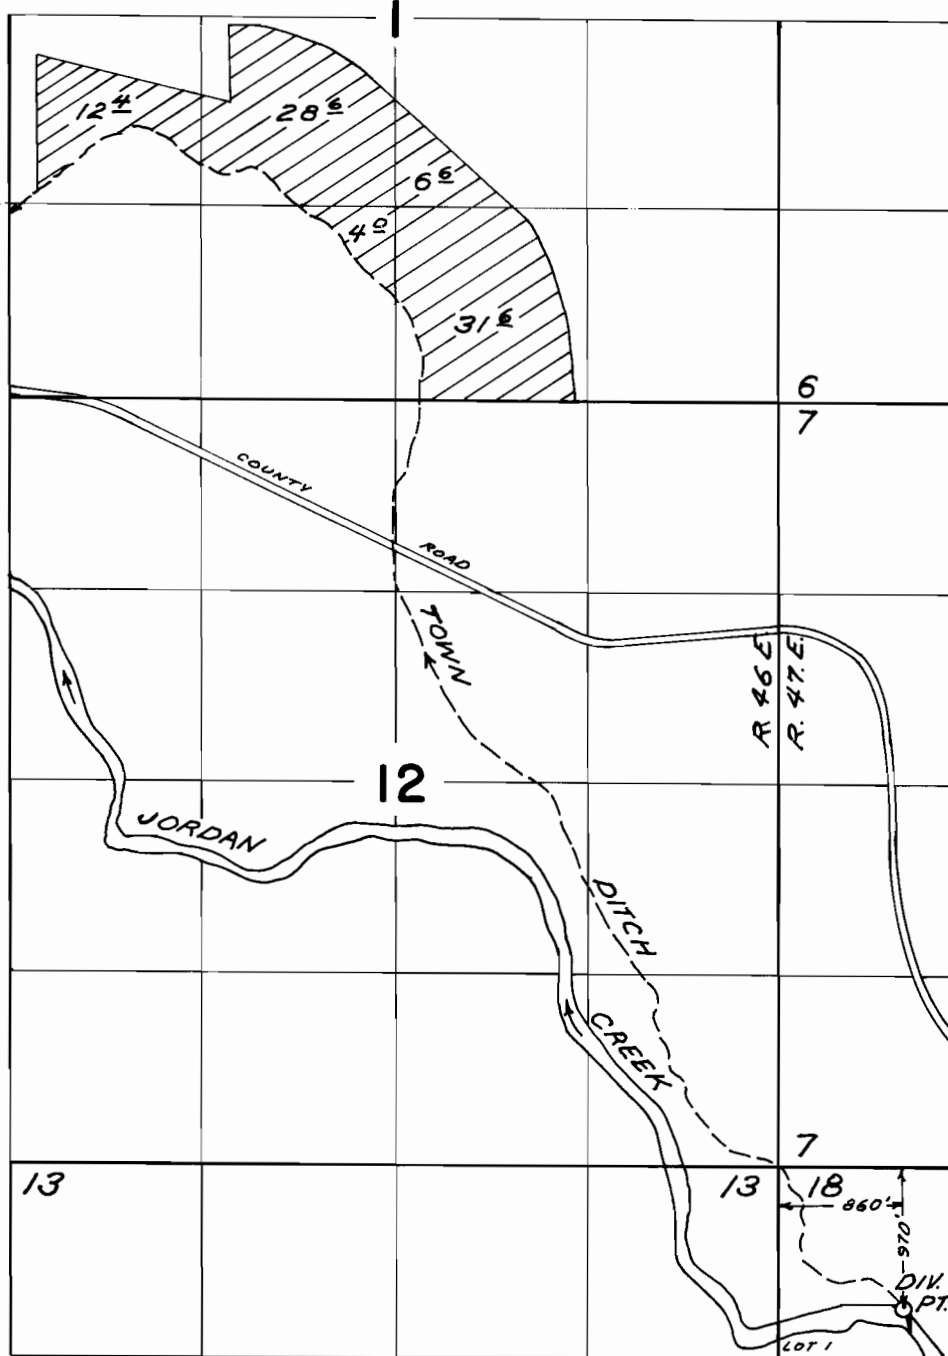

FINAL PROOF SURVEY
UNDER

Application No. 53234 Permit No. 39504
IN NAME OF

OLIVER WENDELL COLLINS

Surveyed JUNE 11, 1976 by L.E. GOULD