


T.9S.,R.3E.,W.M.

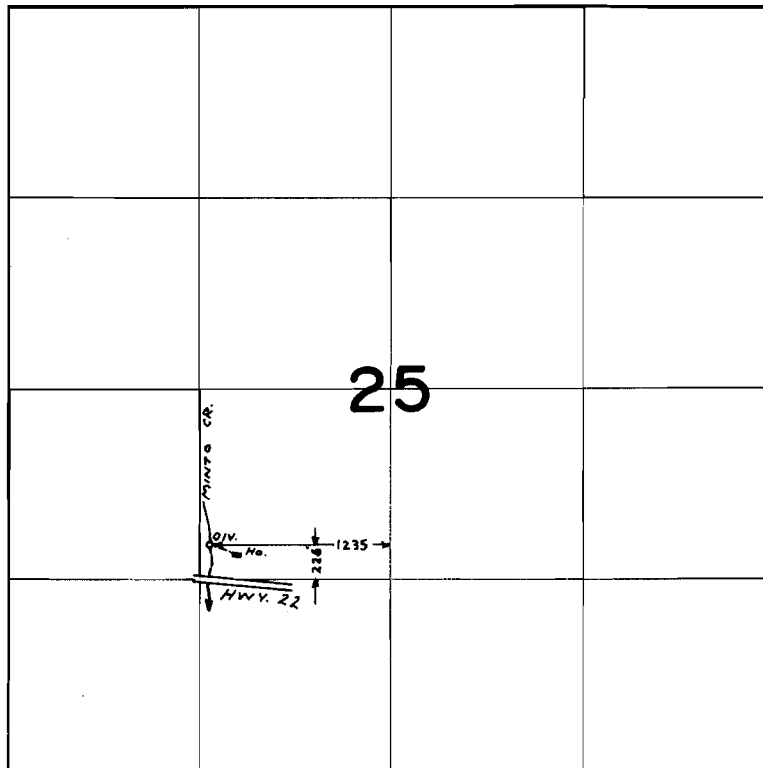

FINAL PROOF SURVEY
UNDER

Application No. 49969 Permit No. 37657
IN NAME OF

JACK STODDARD

Surveyed SEPT. 4 1975, by L. Toll