




T. 5S. R. 1W. W.M.

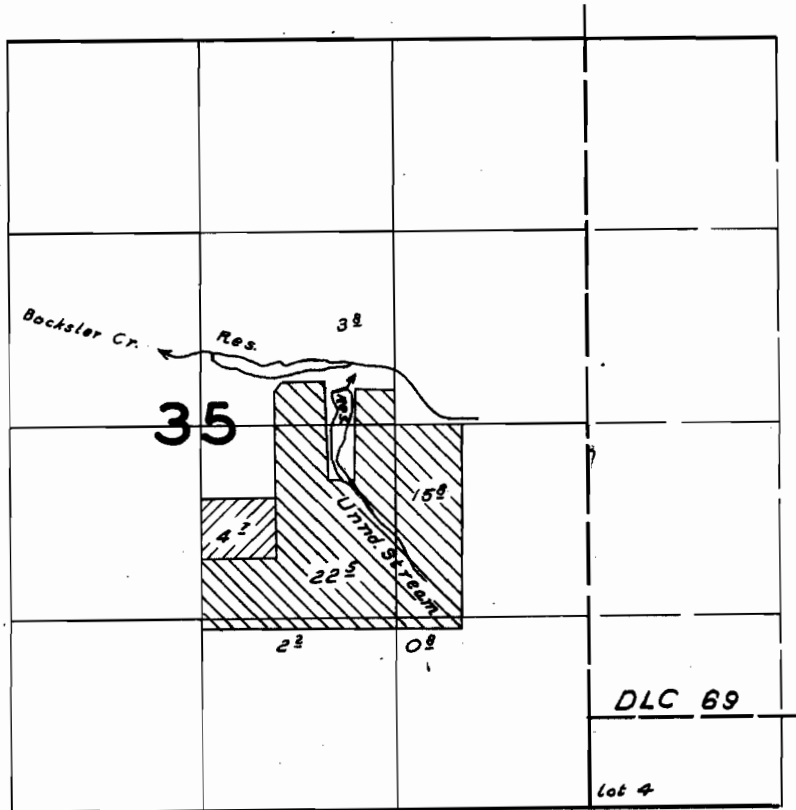

FINAL PROOF SURVEY UNDER

Bocksler Cr. Res.  *Unnd. Str. Res.* 

R31547

R2018

Application No. 31548 Permit No. 24899-
IN NAME OF

Edward J. Zach

Surveyed May 21, 1959, by R.H. Jackson