


T.5S. R.1W.W.M.

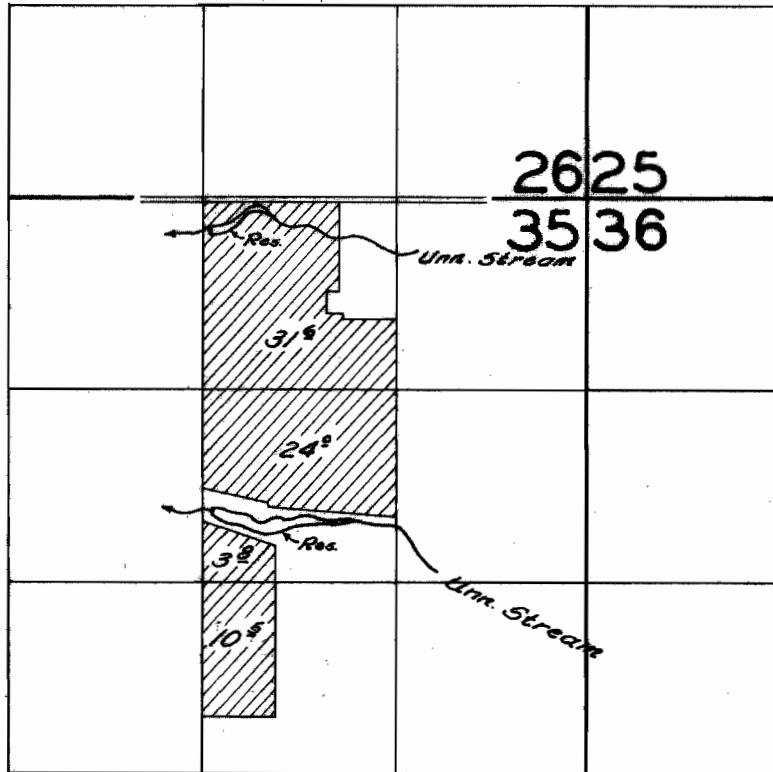

**FINAL PROOF SURVEY**  
UNDER

Application No. <sup>R-28763</sup> 28764. Permit No. <sup>R-1644</sup> 23058.  
IN NAME OF

..... *Ed. Zack* .....

Surveyed *April 25 1958*, by *C.D. Gustaf* .....