


# T.6S. R.2W. W.M.

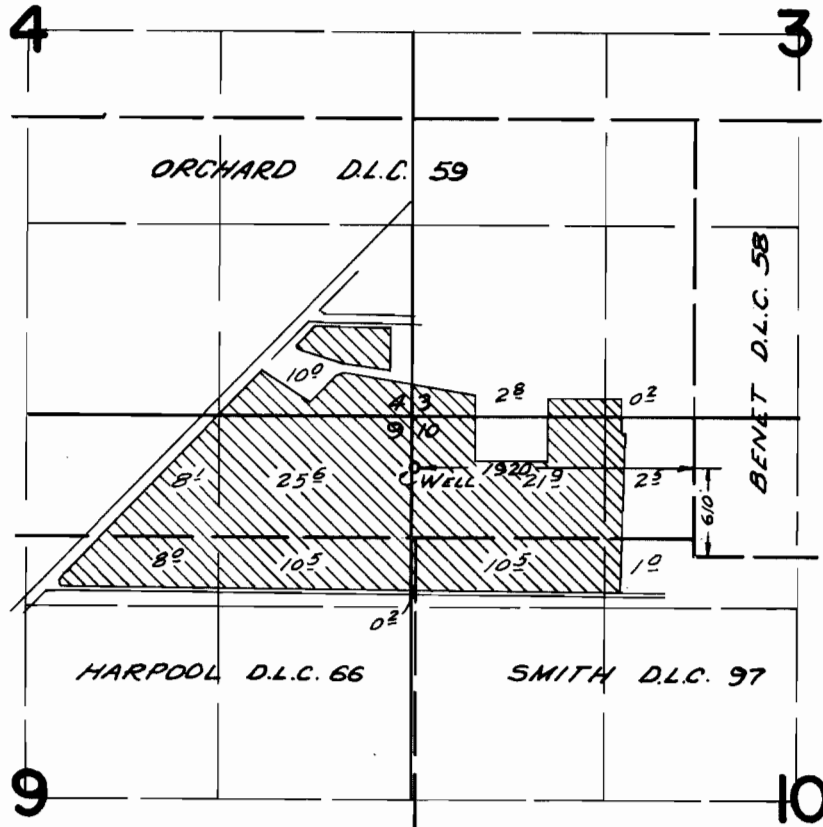

## FINAL PROOF SURVEY UNDER

Application No. *G-4021* Permit No. *G-3771*  
IN NAME OF

*RALPH E. LEBER*

Surveyed *June 20 19.68*, by *V. Garner*