


T.6S.R.1W.W.M.

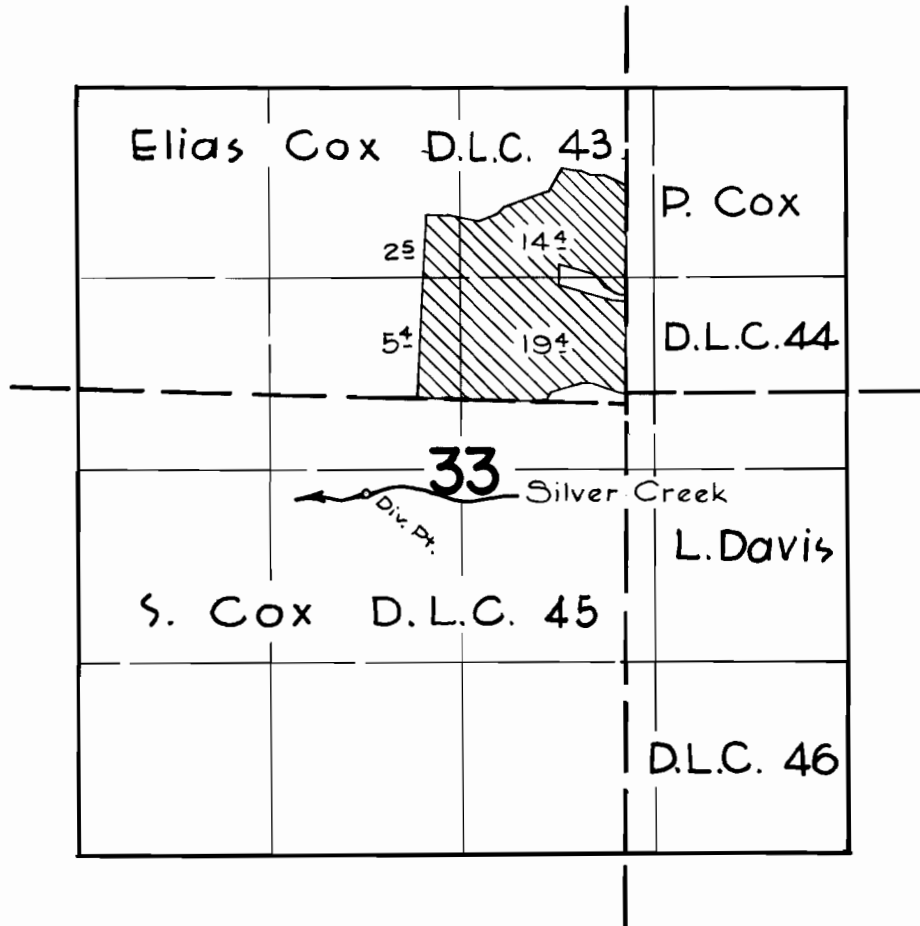

**FINAL PROOF SURVEY**  
UNDER

Application No. 34878 Permit No. 27374  
IN NAME OF

MERLE BOWEN

