


RECEIVED

JAN 31 2001

WATER RESOURCES DEPT
SALEM, OREGON

T.1S. R.4E. W.M.

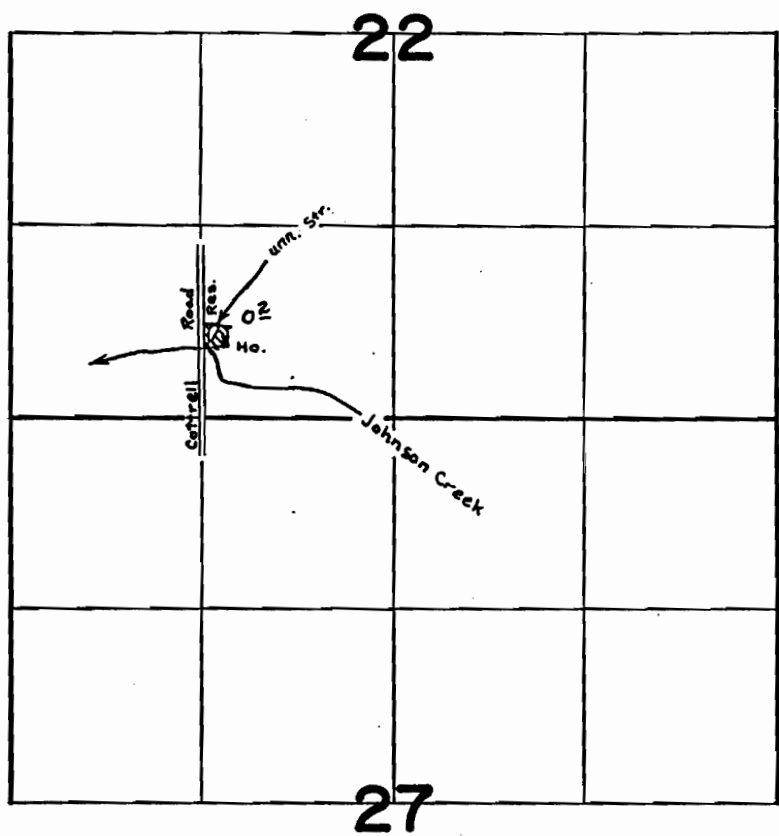

Res. Located : 500' N & 1250' W from S 1/4 cor. Sec. 22

FINAL PROOF SURVEY
UNDER

R-47516 R-5859
Application No. 47753 Permit No. 36170
IN NAME OF

GRANT E. STURM

Surveyed AUG. 11, 1976., by L.E. GOULD