


T.6S.,R.7W.,W.M.

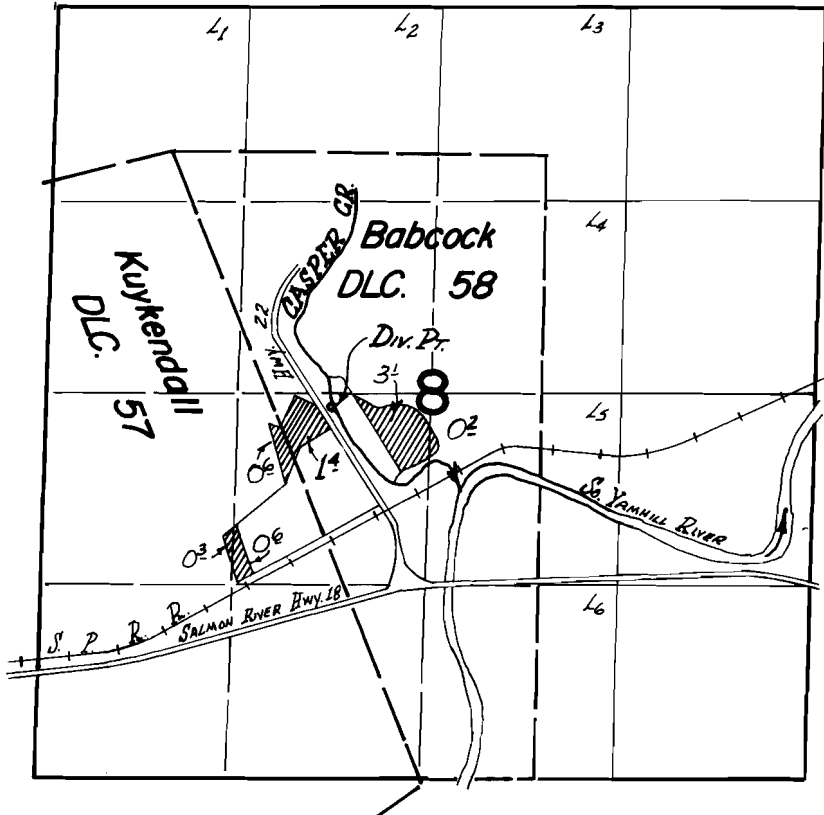

Div. Pt. loc: 2620' N. & 1950' E. FROM SW COR. SEC. 8.

**FINAL PROOF SURVEY**  
UNDER

Application No. 53051 Permit No. 40034  
IN NAME OF

ELMER M. WERTH

Surveyed Aug. 10 1976, by C.R. King