


T. 6S., R. 5W., W.M.

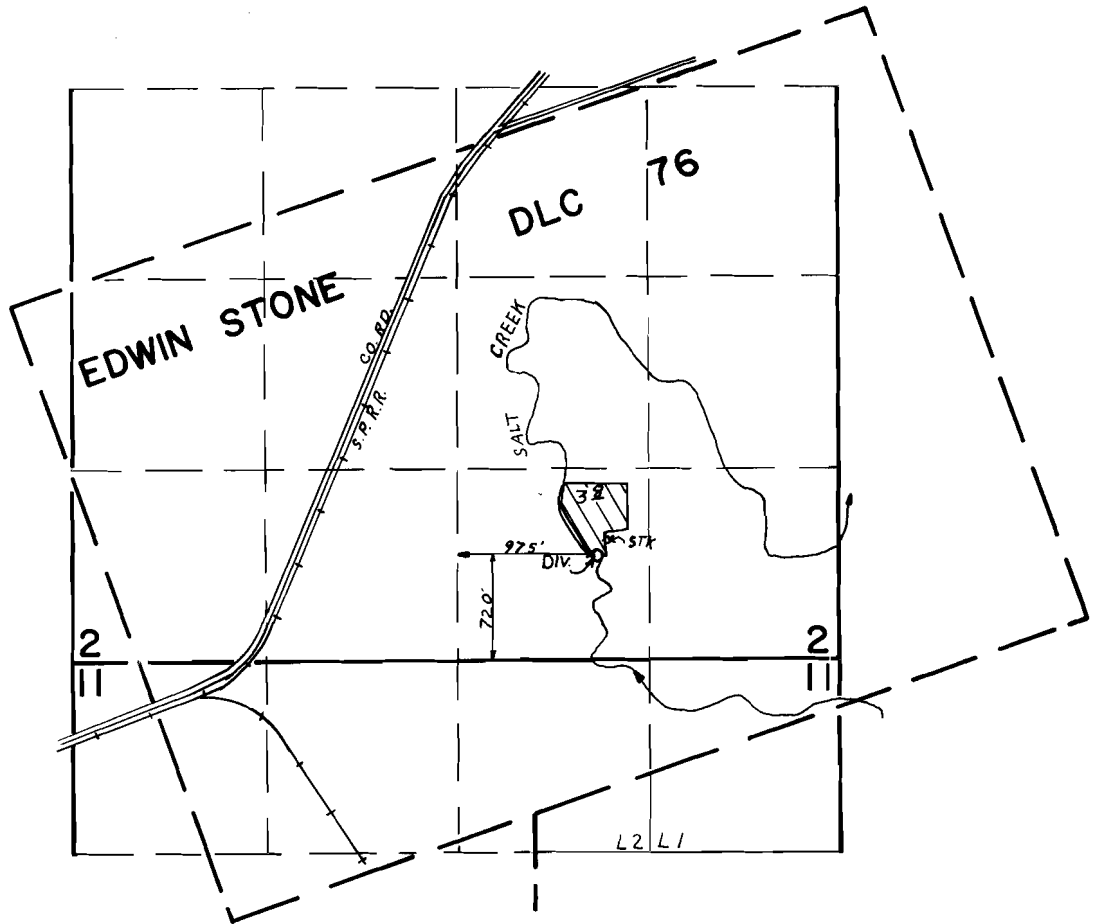

FINAL PROOF SURVEY
UNDER

Application No. 53250 Permit No. 39517
IN NAME OF

WALTER KROENIG

Surveyed AUG. 11. 1976., by C.R. KING.