


T.9S.R.5W.W.M.

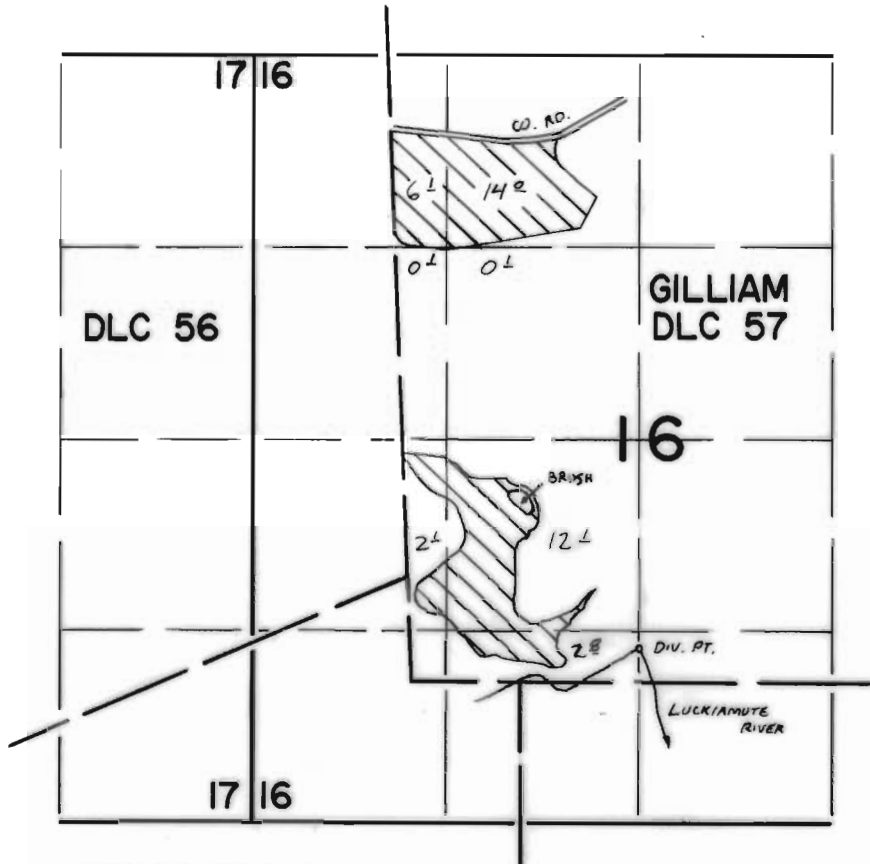

DIVERSION POINT LOCATED 240' N & 1550' W FROM THE SW COR
GILLIAM DLC 57

FINAL PROOF SURVEY
UNDER

Application No. 47785..... Permit No. 35804.....
IN NAME OF

SILVERIO & IDA MANZI

Surveyed MAY 17, 1976, by C. R. KING