


T.8S.R.4W.W.M.

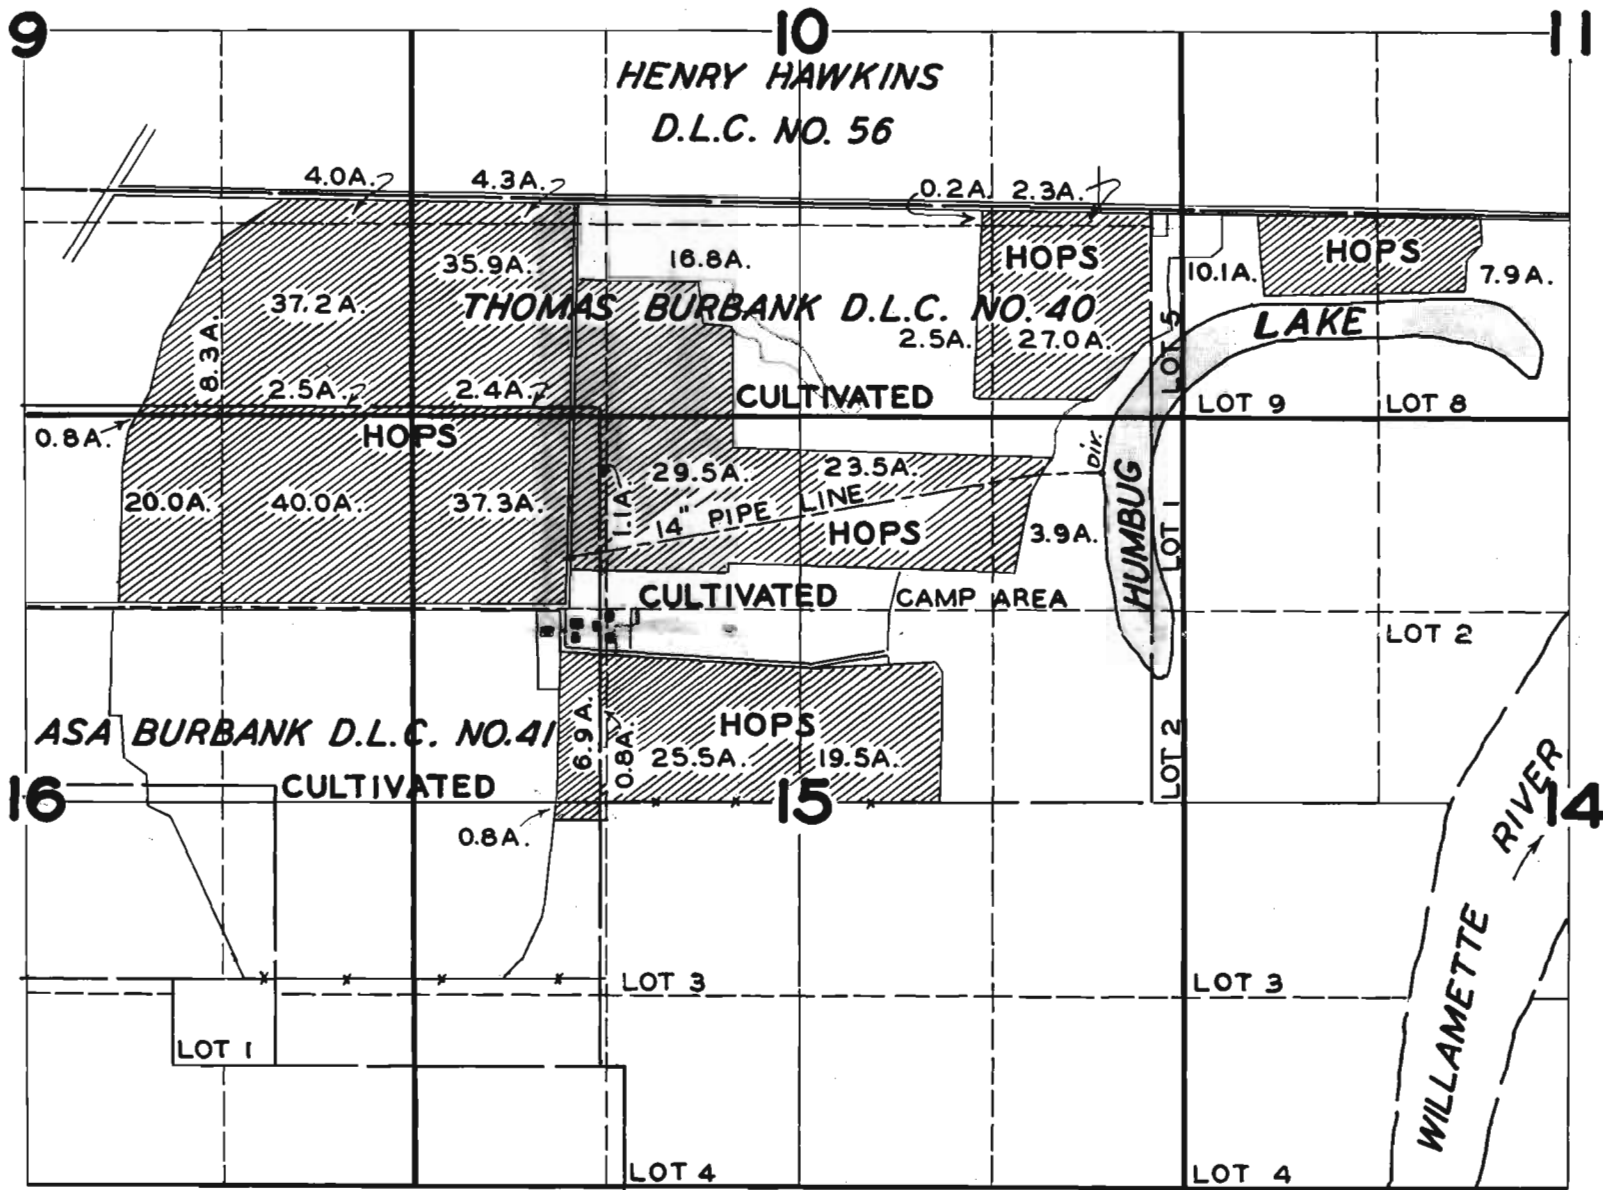

FINAL PROOF SURVEY

UNDER

Application No. 12,208 Permit No. 8615

IN NAME OF

LOUIS LACHMUND ESTATE

Surveyed APR. 13 1948, by JAS. E. BUNNELL