


Basin 76-2905

45706
33493

T.6N. R.35E. W.M.

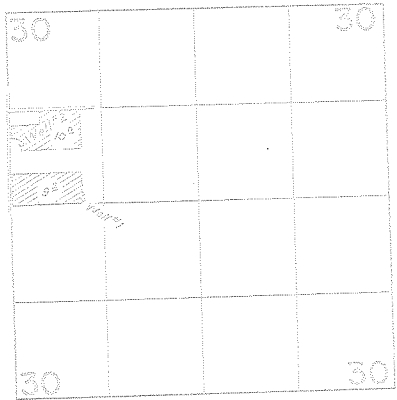

FINAL PROOF SURVEY UNDER

Application No. 9-2600, Permit No. 0-2605,
IN NAME OF

CARL L. & ANITA J. HARRIS

Surveyed April 18, 1964, by R. Jackson.....