# T.1N. R.3W. W.M.

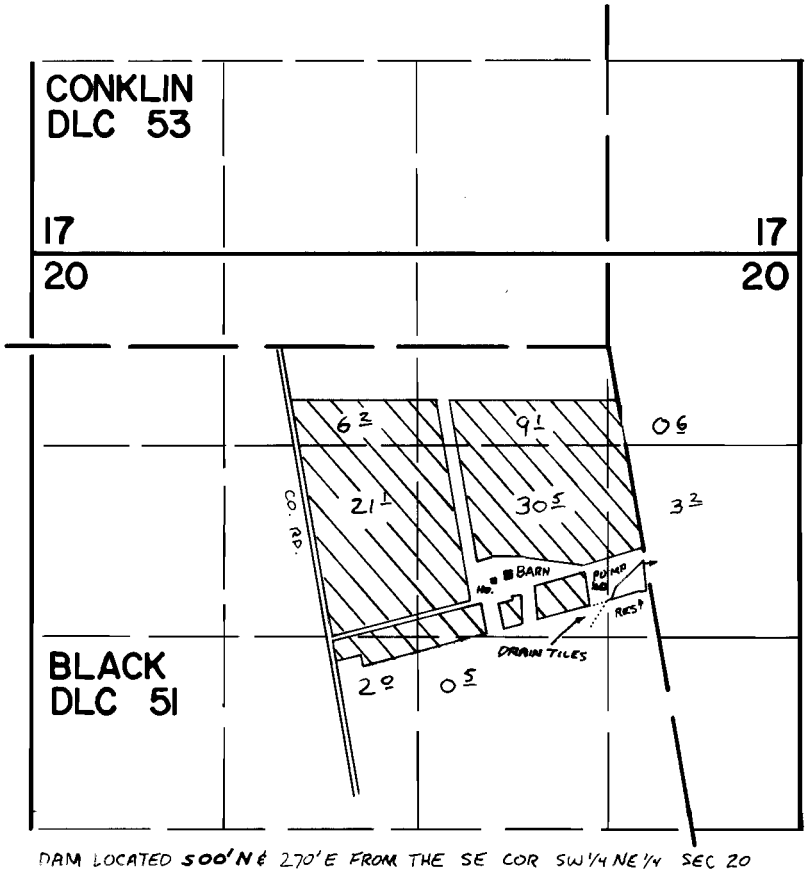


DAM LOCATED 500'N & 270'E FROM THE SE COR SW 1/4 NE 1/4 SEC 20

## FINAL PROOF SURVEY
UNDER

Application No. R-50372 50373 Permit No. R-6147 38022

IN NAME OF

OREGON ROSES, INC.

Surveyed SEPT. 27 1976, by L. E. GOULD

DBS-2LL-190 & PTS 1976-L