


T.2S.R.2W.W.M

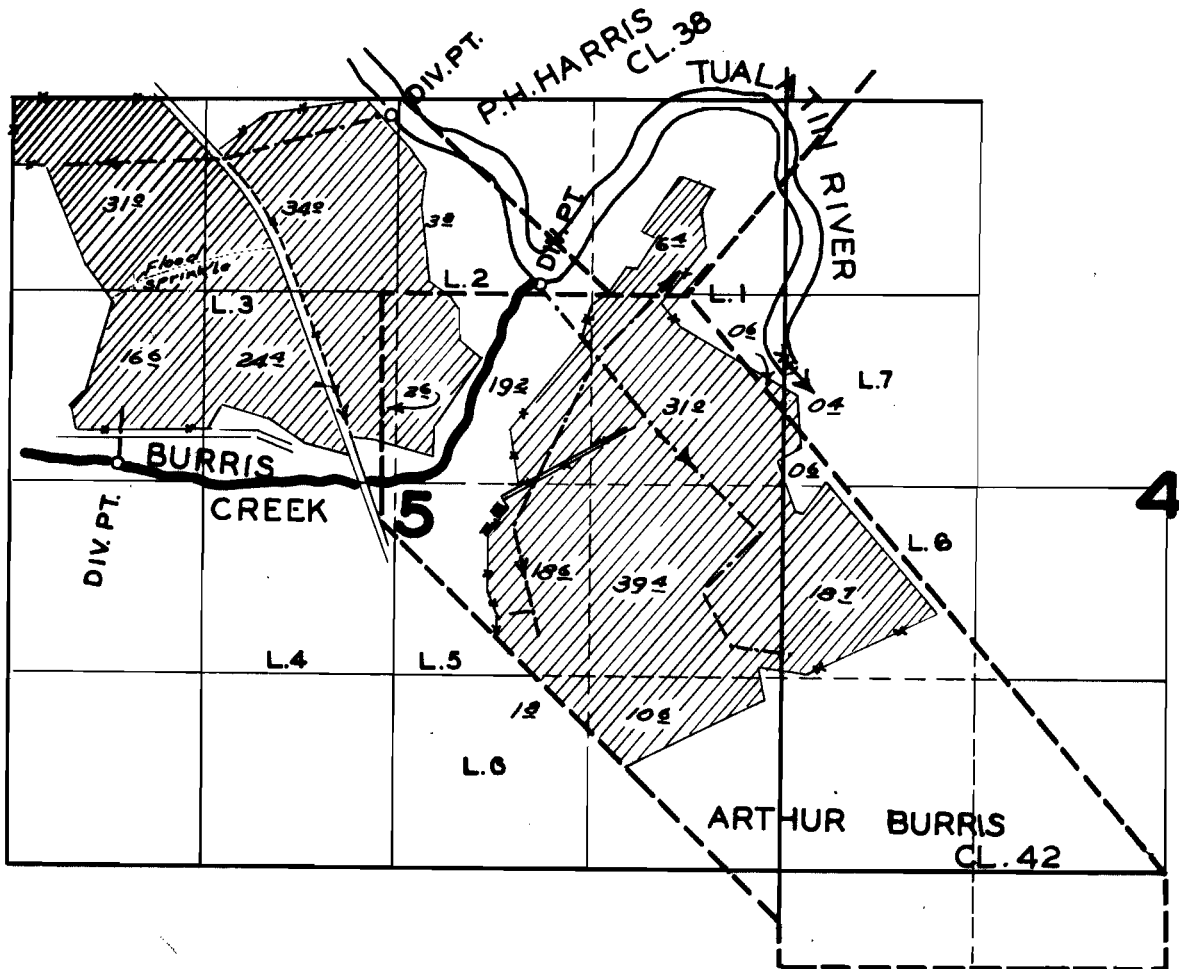

FINAL PROOF SURVEY

UNDER

16499

12297

Application No. 18028.. Permit No. 13696..

IN NAME OF

.....JULIUS CHRISTENSEN.....

Surveyed 7/2..... 1951., by H.L. COFFMAN..