


T.9S., R.23E., W.M.

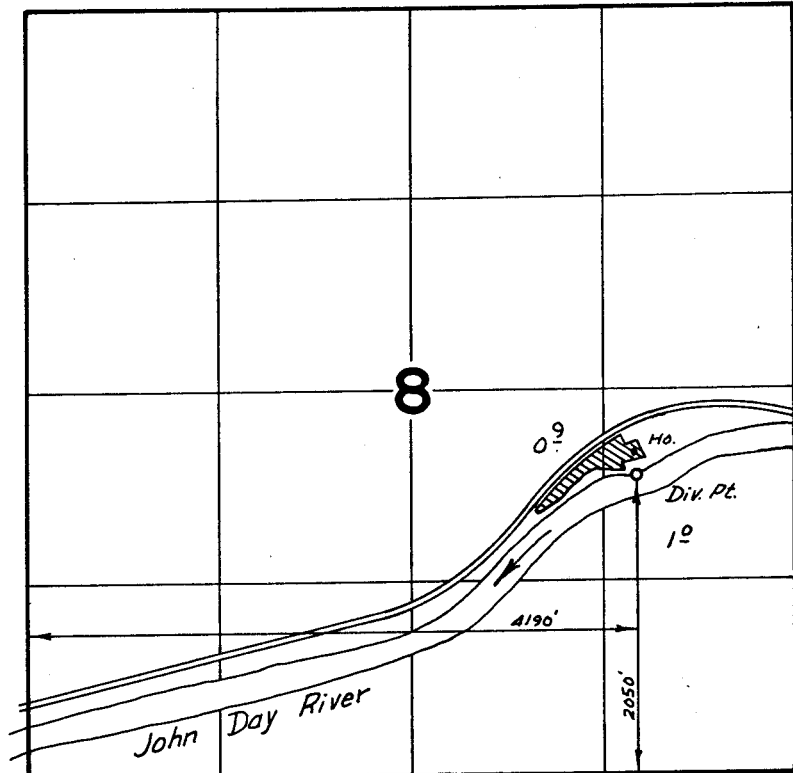

FINAL PROOF SURVEY
UNDER

Application No. 48922 Permit No. 35826
IN NAME OF

DONALD R. McQUINN

Surveyed June 5 1976, by L.M. Toll