


T.7S.,R.46E.,W.M.

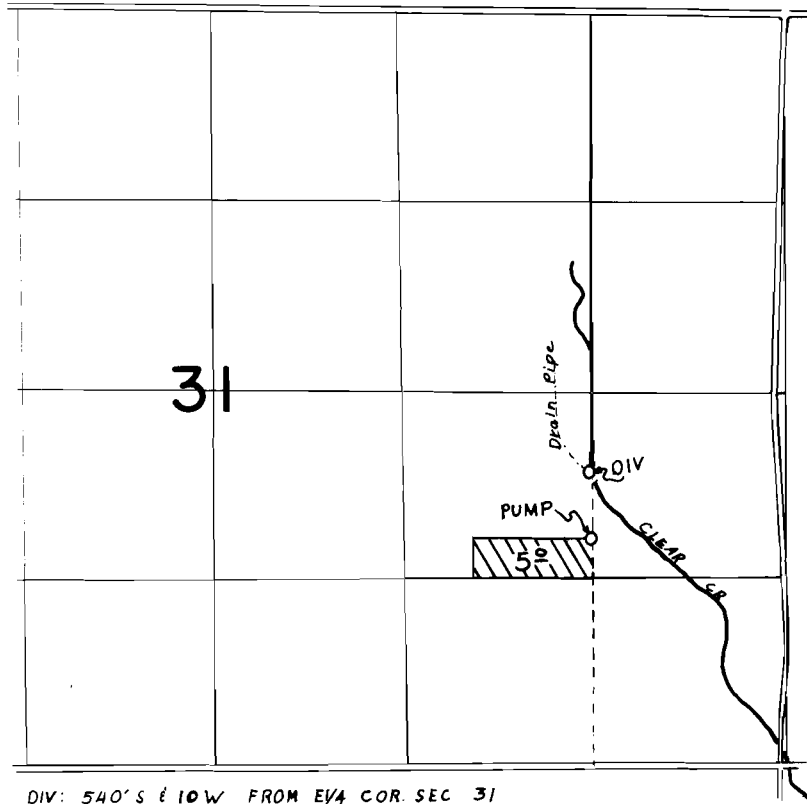

FINAL PROOF SURVEY
UNDER

Application No. G-4449 Permit No. G-4194
IN NAME OF

RICHARD S. TOWELL

Surveyed JUNE 16, 1976, by C.R. KING