

$N. 43^{\circ} 04' E.$   
 525'  
 530'  
 85'  
 60'  
 N.W. 1/4  
 S.W. 1/4  
 PARK BOUNDARY

N.E. 1/4 Sec. 30, T. 9. S. R. 46. E. W. 1/4  
 S.E. 1/4 Sec. 30, T. 9. S. R. 46. E. W. 1/4

$N. 43^{\circ} 04' E.$

W. S. 1/2 2077 Contour Line

Brownlee Reservoir


Swim Buoys

- LEGEND:**
- Existing conc. fire pit
  - ⊠ Existing picnic table w/benches
  - ⊙ Existing trees
  - Solid lines are surveyed objects
  - - - Dash lines are proposed or drawn from other sources.

**HEWITT MEMORIAL PARK**  
 BAKER COUNTY, OREGON

Surveyed July 23, 1966  
 Oct. 25, 1974  
 1" = 50'

*James H. ...*

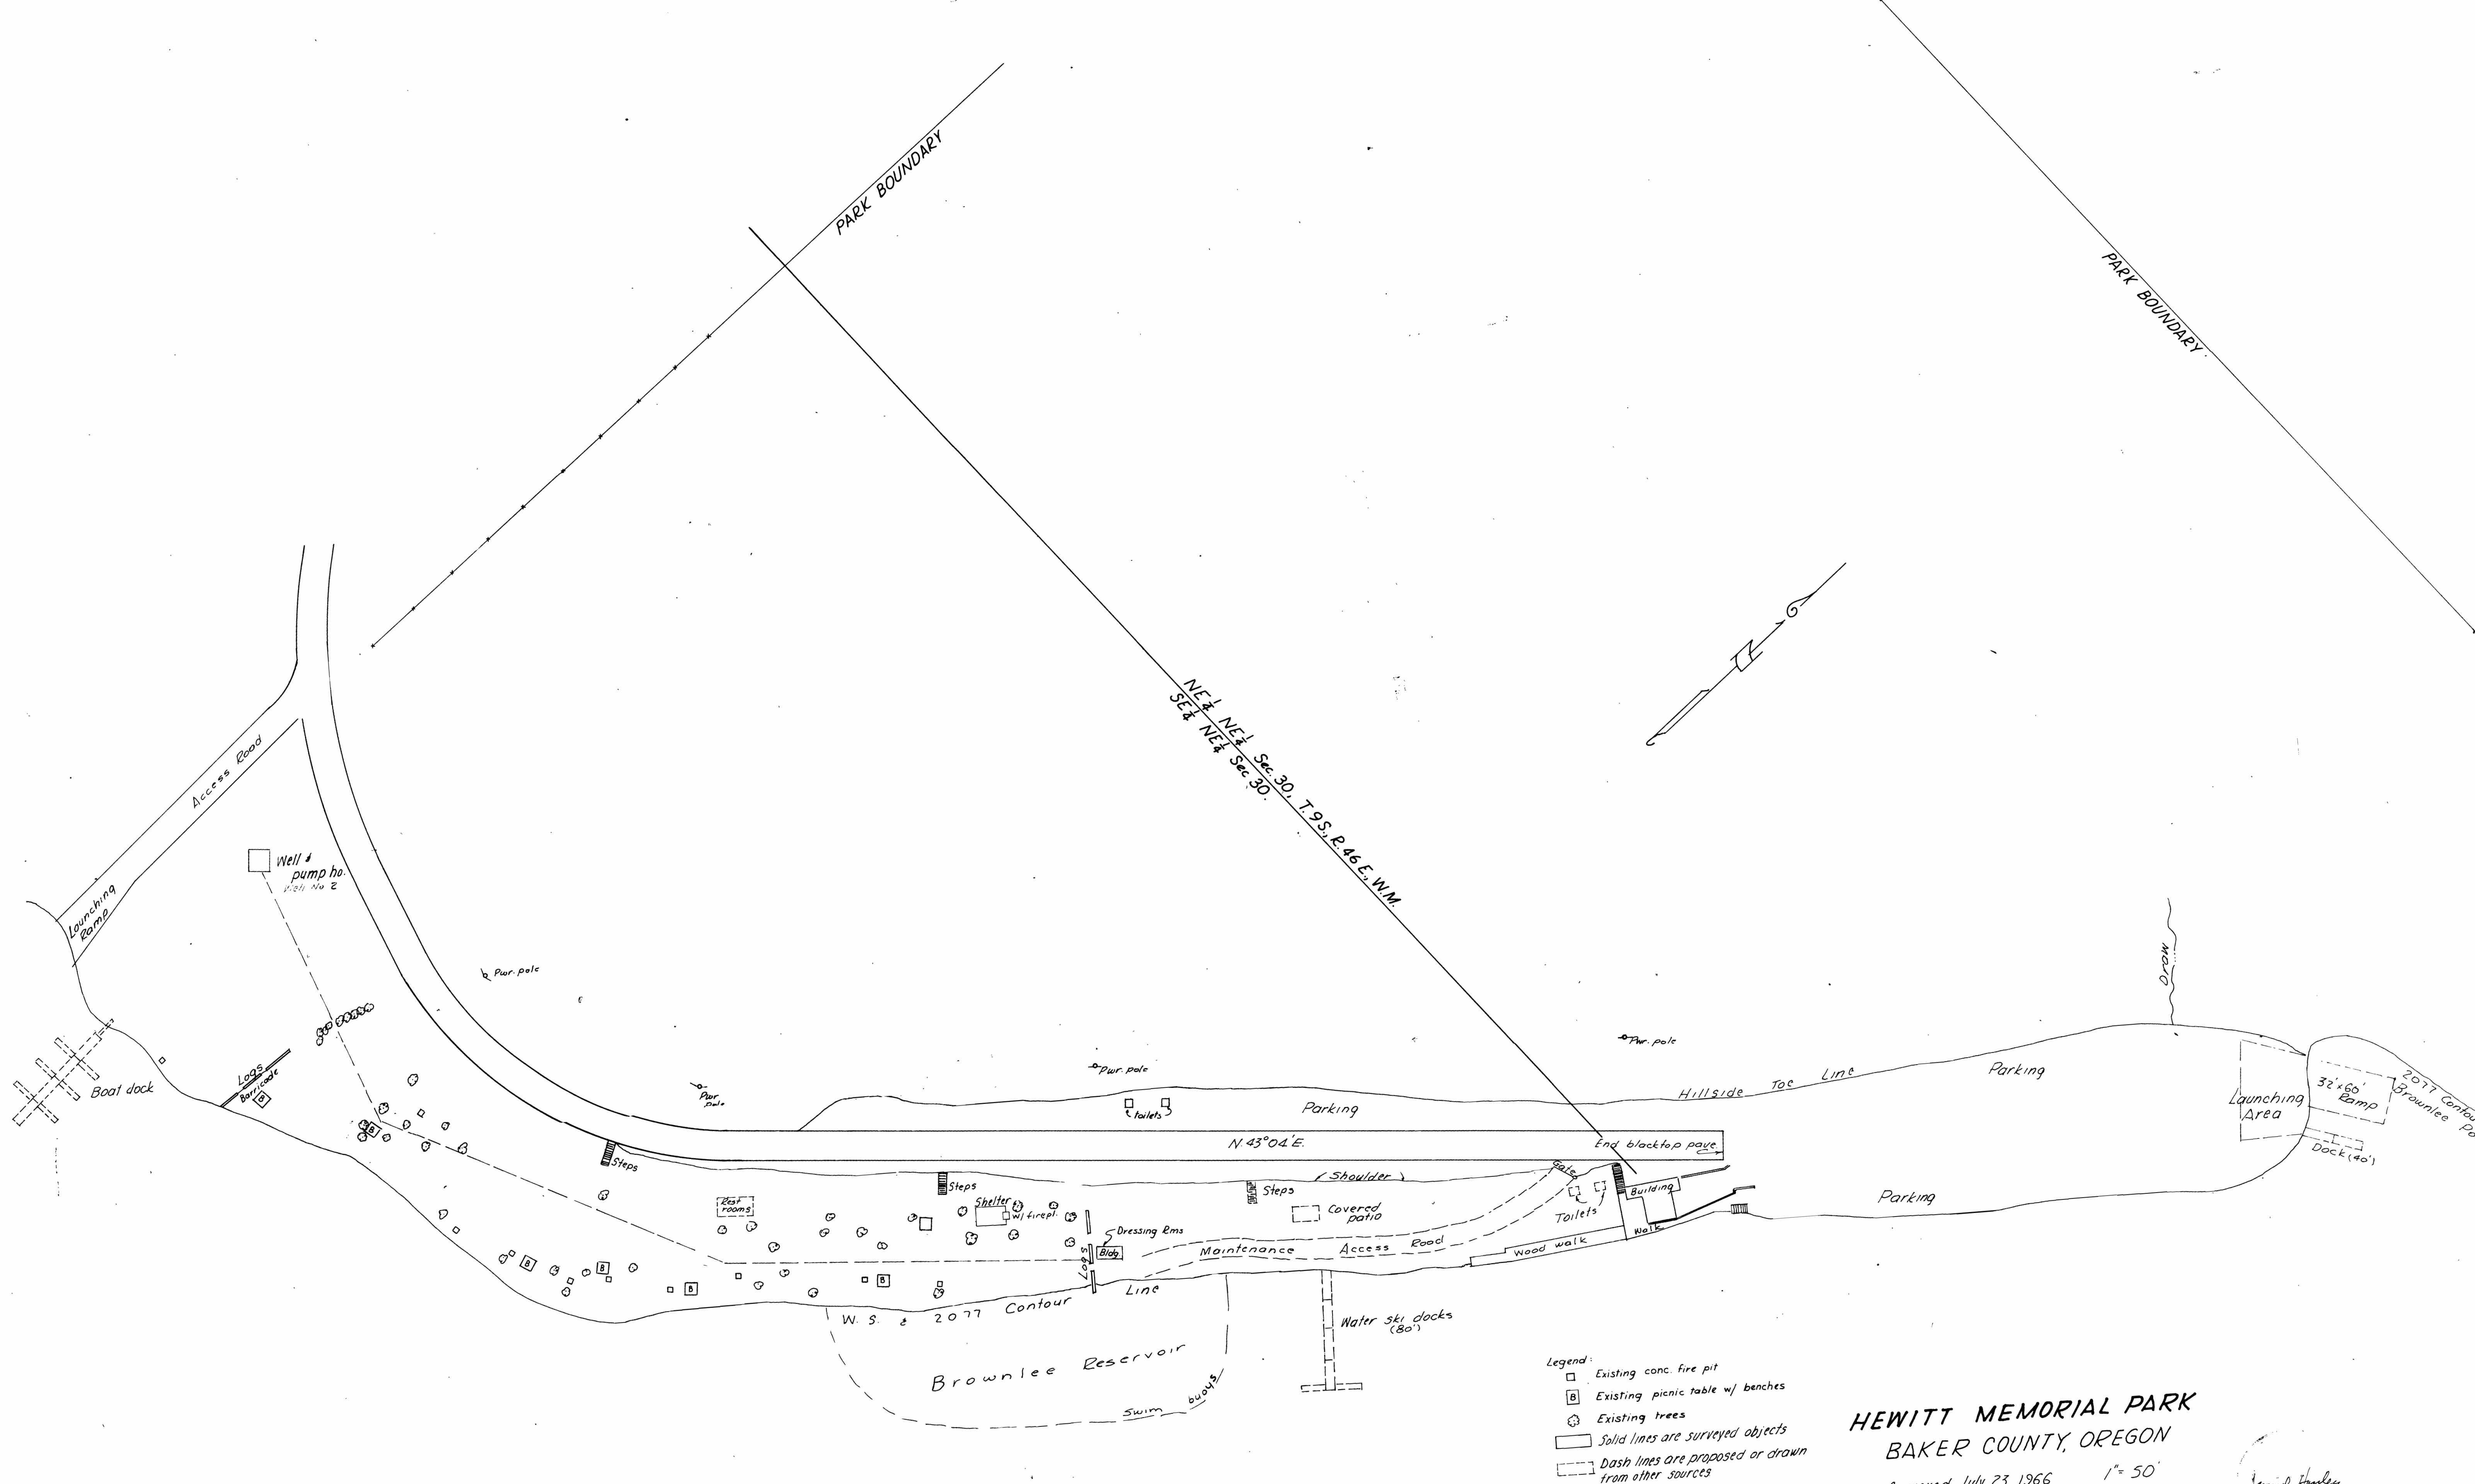

- Legend:
- Existing conc. fire pit
  - ⊞ Existing picnic table w/ benches
  - ⊙ Existing trees
  - Solid lines are surveyed objects
  - - - Dash lines are proposed or drawn from other sources

**HEWITT MEMORIAL PARK**  
**BAKER COUNTY, OREGON**  
 Surveyed July 23, 1966 1" = 50'

*Jamie D. Henley*