


T. 8S. R. 39E. W.M.

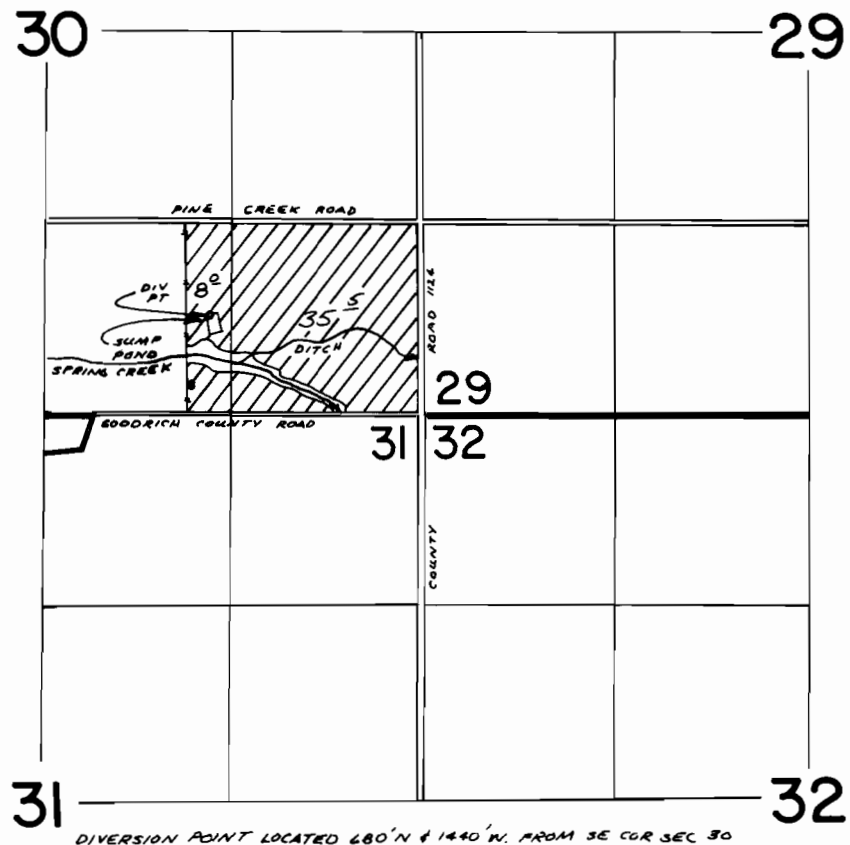

FINAL PROOF SURVEY
UNDER

Application No. G 6938 Permit No. G 6455
IN NAME OF

GLEN W. SWILLING

Surveyed OCT. 28, 1977, by R. BARWIN