


# T. 2 S. R. 3 & 4 E. W.M.

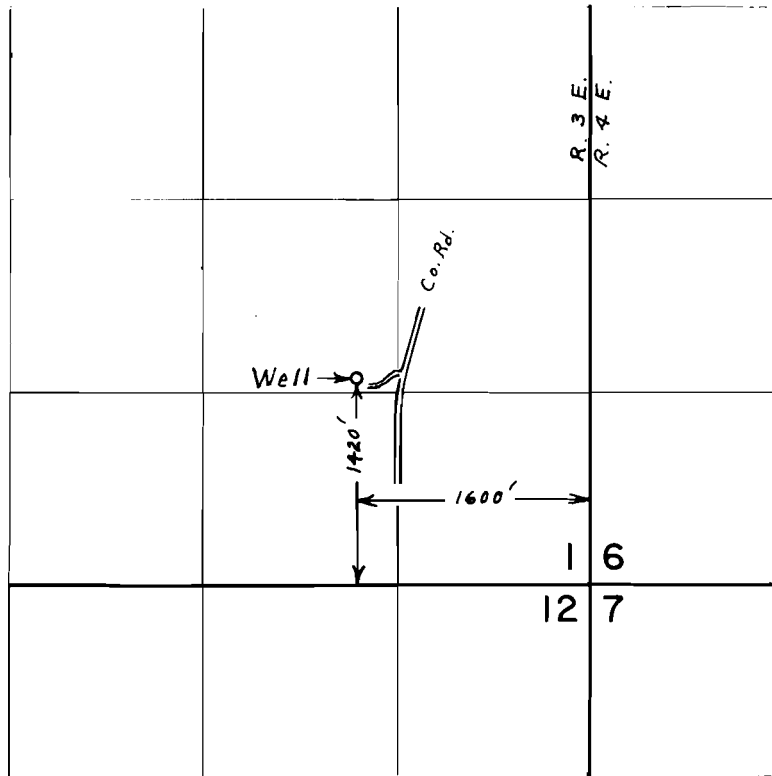

## FINAL PROOF SURVEY UNDER

Application No. G-5392 Permit No. G-5319  
IN NAME OF

BORING WATER DISTRICT

Surveyed Oct. 5, 1976, by L. E. Gould