


T. 4S. R. IW. W.M.

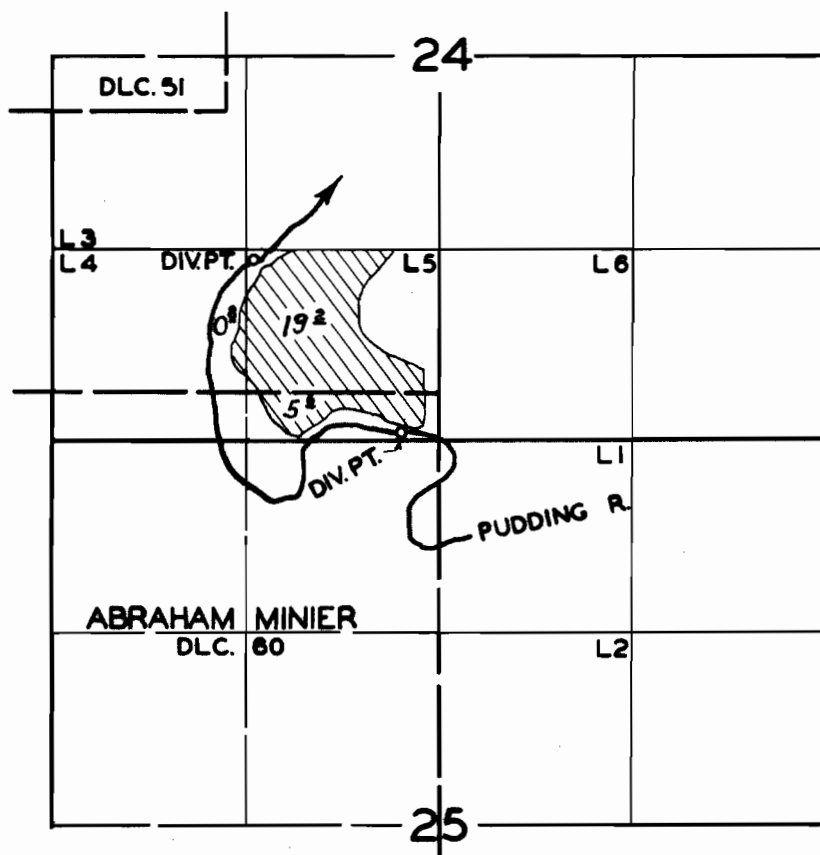

FINAL PROOF SURVEY
UNDER

Application No. **28162** Permit No. **22163**
IN NAME OF

Ranzew H. & Ida M. Petersen

Surveyed **14 MAR. 1956.** by **R.D. BEST**