


T. 3S. R. 2E. W.M.

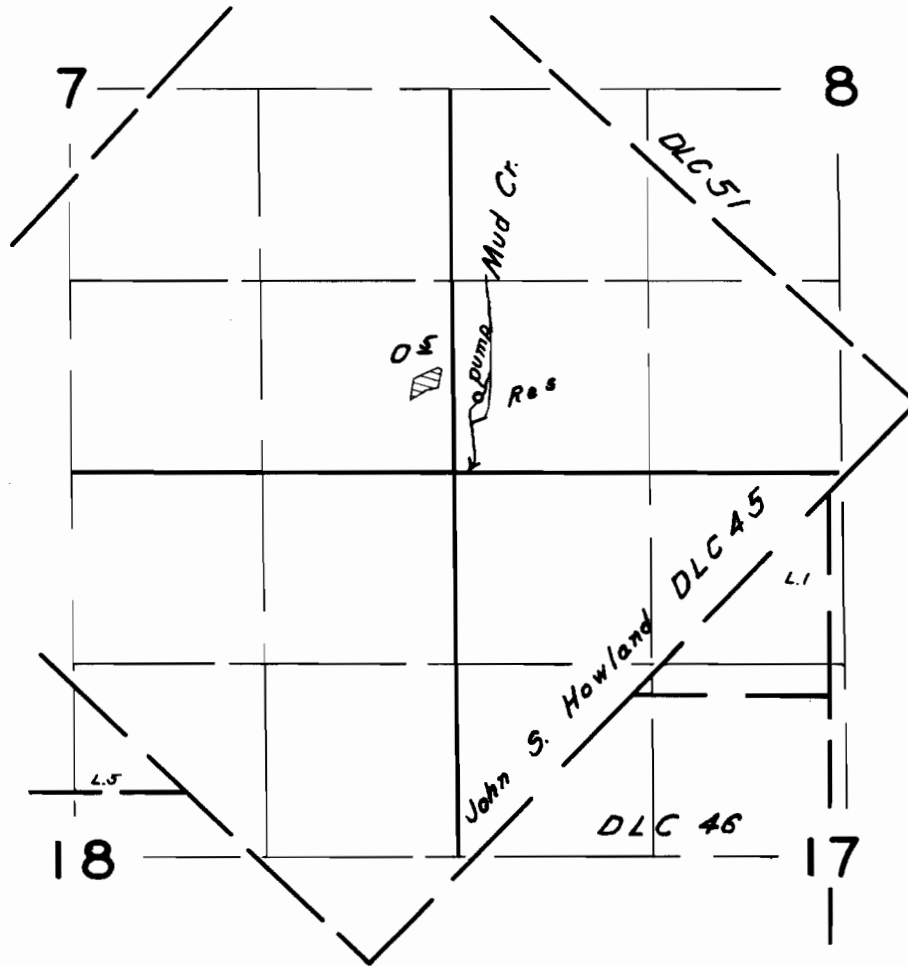

FINAL PROOF SURVEY
UNDER

R-28596 R-1545
Application No. ~~28597~~ Permit No. ~~22529~~
IN NAME OF

S. Ely

Surveyed July 1, 1958, by W.N. Perry