


T.3S. R.3E. W.M.

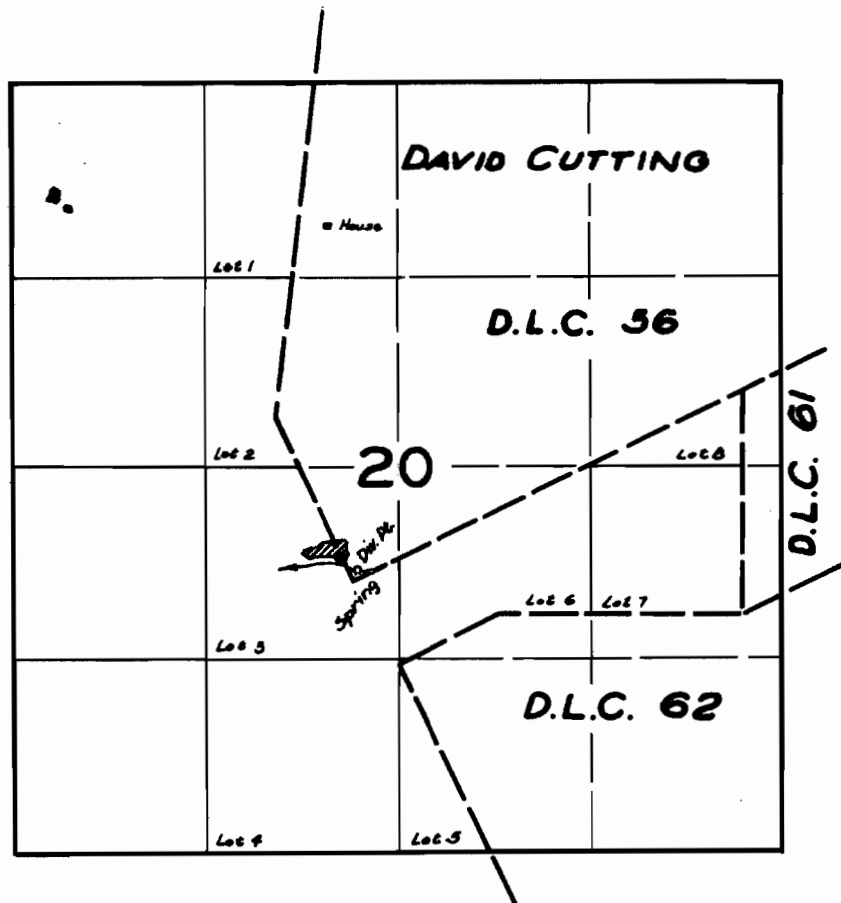

FINAL PROOF SURVEY
UNDER

Application No. 32208. Permit No. 25413.
IN NAME OF

CLIFF & ALICE OPPY

Surveyed 10 Oct. 1958, by C.O. Bartels