


T.8N.,R.7W.,W.M.

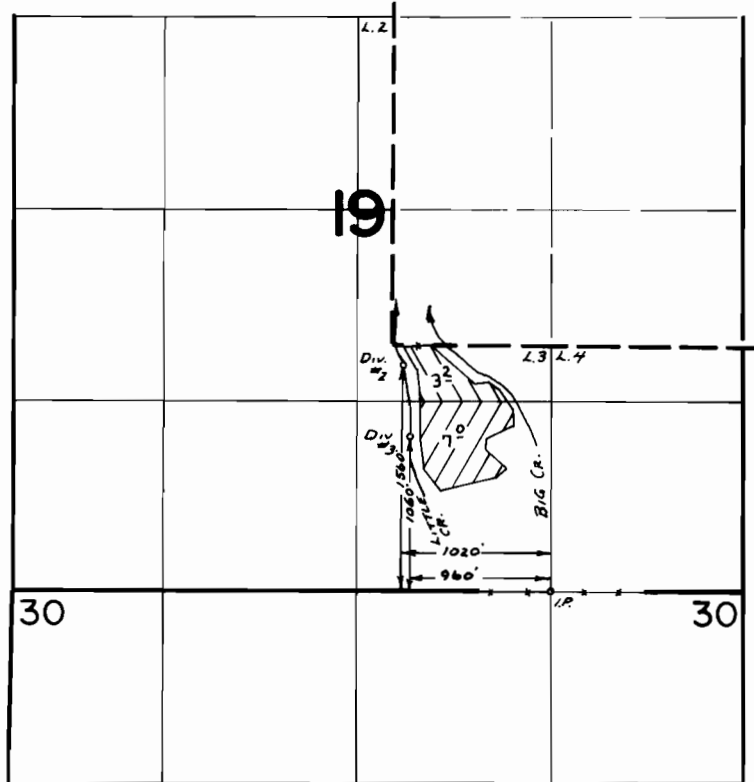

 - IRRIGATED UNDER PERMIT 30468
- IRRIGATED UNDER PERMIT 35043

FINAL PROOF SURVEY UNDER

Application No. 40870 Permit No. 30468
46872 Permit No. 35043
IN NAME OF

FRANK R. MUDGE

Surveyed JUNE 22 1976, by L. TOLL