


T.305, R.15 W.W.M.

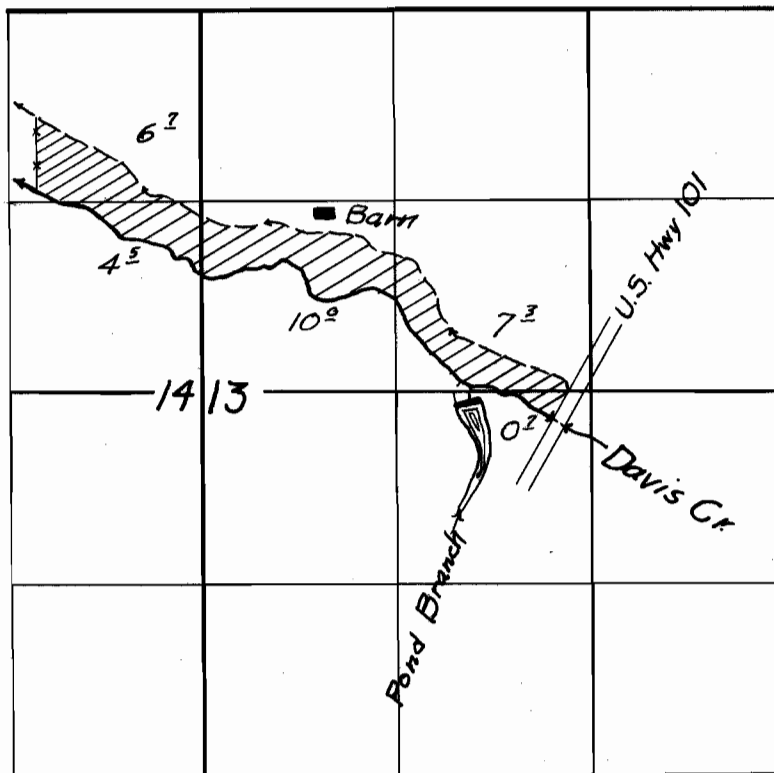

FINAL PROOF SURVEY

UNDER

Application No. 26927... Permit No. 20725.

IN NAME OF

J. I. EVEREST

Surveyed 14 March, 1955, by H.L. Coffman.